

FRANKLIN
D6
4-18-74

MISSISSIPPI
BOARD OF WATER COMMISSIONERS
416 North State Street
Jackson, Mississippi 39201

CODED

WATER WELL DRILLERS LOG

4-18 1974 *Fitzgerald Well Co* Franklin
date well completed firm name county well located

LANDOWNER:
J.C. Loucletone
R.R. Drake Miss.
(mailing address)


description of formations encountered	from	to
<i>Red clay</i>	<i>8</i>	<i>10</i>
<i>Red + white sand</i>	<i>10</i>	<i>95</i>
<i>Green sand</i>	<i>95</i>	<i>110</i>

WELL LOCATION:
sec. *35* T. *7* N. R. *4* E
3 miles *N* of *Edgewater*
(distance) (direction) (nearest town)

WELL PURPOSE: *Home*
(home, irrigation, municipal, industrial)

WELL COMPLETION DATA:
(1) diameter (inches) *4*
(2) total depth (feet) *110*
(3) static water level (feet) *15* below above top of ground.
(4) casing *plastic*, *102*,
(material) (depth)
4 if telescope see back.
(size)
(5) screen *8*, *102*
(length) (depth to top)
4, *plastic*
(size) (material)
(6) pump *1/2*, *10*
(HP) (yield gpm)
elec
(type power)
(7) electric log *no*
(yes or no)
(organization running log)
(8) how well bottom plugged *lol shak*

CODED

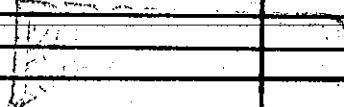

MAY 1 1974

DRILLERS REMARKS: