

FRANKLIN MISSISSIPPI BOARD OF WATER COMMISSIONERS

E2

CODED

WATER WELL DRILLERS LOG

CODED

9-12-62

Date: 9-12, 1962, Driller: Herring Pump Co County FRANKLIN  
(Name)

(1) Owner of Land:	Description & Color of Materials Sand, Clay, Red Clay, Shell, etc.	Thick- ness Feet	Depth Feet
EDGAR SMITH (Name) McCALL CREEK RT 1 (Address)	SAND Red CLAY SAND		60 50 20
(2) Location: 1/4, 1/4, Sec. 21 T. 7 R. 5			
1/4 miles NORTH of McCALL (distance) (direction) (Nearest Town)			
(3) Topography: <del>_____</del> (Hilly) (Flat) (Level)			
(4) Purpose of Well: DOMESTIC (Domestic Irrigation Municipal, Industrial, Other)			

Information upon completion of well:


- (1) Diameter  $2\frac{3}{4}$  inches.
- (2) Total Depth 110' feet.
- (3) Water Level 90 feet below top of ground.
- (4) Cased to \_\_\_\_\_, Size \_\_\_\_\_.
- (5) Screen: Size 2, Length 5''.
- (6) Were any formations sealed against pollution?  
 yes, \_\_\_\_\_ no.

If YES depth of formation \_\_\_\_\_

Why \_\_\_\_\_

Drillers Remarks: \_\_\_\_\_

CODED

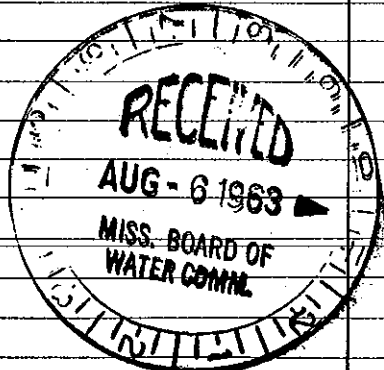

(Use Back Side)

Well No.