

# State Well Report

Part 1

Mississippi Department of Environmental Quality  
Office of Land and Water Resources  
P.O. Box 10631  
Jackson, MS 39289-0631  
(601)961-5210  
(601)354-6938 (fax)

For Office Use Only:

Aquifer: E 44  
Well #: \_\_\_\_\_  
L. S. Elevation: \_\_\_\_\_  
E-log #: \_\_\_\_\_

County: Franklin  
Permit #: \_\_\_\_\_  
Driller: GRENN WATER WELL & SUPPLY, INC  
Date drilling completed: 5-9-11

State Law requires that this report be prepared by the driller in detail and filed with the Department within 30 days of completion of drilling of the well.

Well Owner Information	Well Location
Owner Name: <u>Brian POVE</u>	Latitude: <u>31.33.16<sup>09</sup></u> Longitude: <u>90.41.45<sup>27</sup></u>
Mailing Address: <u>1203 Shucktown Rd NE</u>	Method of Lat/Long (circle one): <u>Conventional Survey</u>
<u>Mc Call Creek MS 39647</u>	USGS quad, <u>Hand-held GPS</u> , Survey-grade GPS
City State Zip Code	<u>NW 1/4 NE 1/4 Sec 27 Twn SE Rng 7 N</u>
Telephone No. <u>(601) 669-1463</u>	Distance Direction Nearest Town <u>3</u> Miles <u>N</u> of <u>LUCIEN</u>

Well Data

Purpose of Well (circle one) Home Industrial Public Supply Irrigation Fish Culture Other: \_\_\_\_\_

Date well drilling started: 5-9-11 Date well drilling completed: 5-9-11

If flowing, method of flow regulation: Valve \_\_\_\_\_ Other (describe) \_\_\_\_\_

Static Water Level: 148 feet above or below (circle one) land surface Date measured: 5-9-11

Method of Measurement (circle one) steel tape electric tape air line other: \_\_\_\_\_

Hole depth: 285 Well depth: 270 Well grouted to a depth of 10 feet

Type of grout (circle one): Cement Bentonite Mix

Casing length: 260 feet Casing diameter: 4 inches Type of casing: PVC

Screen length: 10 feet Screen diameter: 4 inches Type of screen: PVC

Screen slot size: .010 inches Setting depth: From 260 feet to 270 feet

Type of completion (circle all applicable): Gravel packed Underreamed Telescoped Open hole Natural Development

Other (describe): \_\_\_\_\_

Top of lap pipe or reduction in casing: \_\_\_\_\_ feet. If telescoped or more than one screen, describe on back of page

Logs run (circle all applicable): No log run Electric Gamma Ray Density Sonic Neutron Other: \_\_\_\_\_

Name of organization running log(s): \_\_\_\_\_

I certify that the well was drilled, constructed, and completed in accordance with all applicable requirements of the Mississippi Department of Environmental Quality and/or the Mississippi Department of Health regulations and state laws.

GRENN WATER WELL & SUPPLY, INC.

Brian McClendon, lic. no. 0-664

Print Name of Water Well Contractor and License No.

Signature of Water Well Contractor

Brian McClendon

RECEIVED

MAY 26 2011

BY: OLWR


If well telescopes please sketch below and show depths.

Ground Level

Description of Formations Encountered	From	To
red clay	0	16
sand & gravel	16	74
white clay	74	80
sand & gravel	80	170
yellow clay	170	182
white clay	182	185
mixed clay streaks	185	241
sand	241	272
white clay	272	285

If more than one screen, show location of each on sketch

Sketch the property layout and include the following: 1) the well location; 2) any permanent structures on the property that may aid in locating the well; 3) any roads, power lines, or other items that may aid in locating the property and the well; 4) indicate direction.

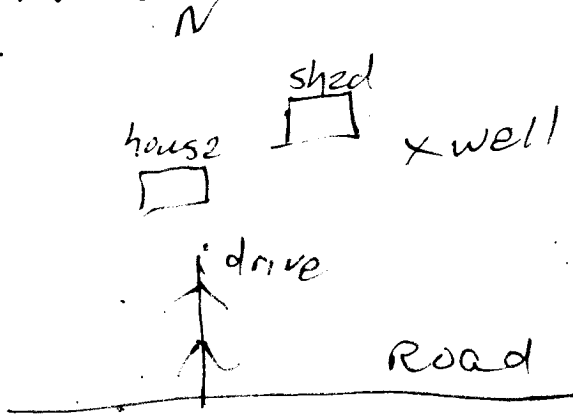

Landowner Name: Brian Powe

Brian McClendon  
Signature of Water Well Contractor

Brian McClendon, lic. no. 0-664  
GRENN WATER WELL & SUPPLY, INC.

# STATE WELL REPORT

## Part 2

**Pump Installer's Completion Report**  
 Mississippi Department of Environmental Quality  
 Office of Land and Water Resources  
 P.O. Box 10631  
 Jackson, MS 39289-0631  
 (601)961-5210  
 (601)354-6938 (fax)

For Office Use Only:

Aquifer: \_\_\_\_\_  
 Well #: \_\_\_\_\_  
 Elevation: \_\_\_\_\_

County: Franklin  
 Permit #: \_\_\_\_\_  
 Driller: GRENN WATER WELL & SUPPLY, INC.  
 Date completed: 5-9-11

This report should be prepared by the pump installer in detail and filed with the Department within 30 days of the installation of pump.

Well Owner Information	Well Location
Owner Name: <u>BRIAN POWE</u>	Latitude: <u>31.33.161</u> Longitude: <u>90.41.456</u>
Mailing Address: <u>1203 Shucktown Rd NE</u>	Method of Lat/Long (circle one): Conventional Survey, USGS quad, <u>Hand-held GPS</u> , Survey-grade GPS
<u>McCall Creek MS 39647</u> City State Zip Code	<u>NW 1/4 NE 1/4 Sec 27 Twn 5E Rng 7N</u>
Telephone No. <u>(601)-669-1463</u>	Distance Direction Nearest Town <u>3 Miles N of LUCIEN</u>

Pump Type Circle one	Power Type Circle one
Air Lift Jet <u>Submersible</u>	Diesel Engine Gasoline Engine Natural Gas
Bucket Piston Turbine	<u>Electric Motor</u> Hand Tractor PTO
Centrifugal Rotary Flowing Well	Windmill Other (specify): _____
Other (specify): _____	Horse Power Rating of Motor: <u>1</u>
Date Pump Installed: <u>5-10-11</u>	Setting Depth: <u>178</u> feet
Rated Pump Capacity: <u>10</u> Gallons Per Minute	Number of Stages: <u>9</u>

Pump Test Data	Method of Measuring Water Level Circle one
Date Well Tested: <u>5-10-11</u>	Air Line <u>Electric Measuring Line</u> Steel Tape
Static Water Level (A): <u>148</u> Feet Below Land Surface	Other (specify): _____
Pumping Water Level (B): <u>148</u> Feet Below Land Surface	For flowing well, measured shut in head: _____ feet
Drawdown [(B) - (A)]: <u>158</u> Feet Below Land Surface	Well yielded <u>10</u> GPM with a drawdown of <u>10</u> feet after <u>4</u> hours of pumping
Test Pumping Rate: <u>10</u> Gallons Per Minute	
Duration of Pump Test (minimum 4 hours): <u>4</u> hours	

I HEREBY CERTIFY that the above statements are true to the best of my knowledge.

GRENN WATER WELL & SUPPLY, INC.  
 MICHAEL W. KEES, LIC. NO. 0-801P

Print Name of Pump Installer and License No. (if applicable)

Michael W. Kees  
 Signature of Pump Installer

RECEIVED

MAY 26 2011

BY: OLWR