. 3	State w	en Keport	For Office Use Only:	
County: Franklin		art 1		
•		of Environmental Quality	Aquifer:	
Permit #:		nd Water Resources ox 10631	Well #:E51	
Driller: Gary Rayborn	1	S 39289-0631	L. S. Elevation:	
Date drilling completed: 12 26 12	,	961-5210		
	(601)354	1-6938 (fax)	E-log #:	
State Law requires that this rep	ort be prepared by the	driller in detail and filed w	rith the Department within	
30 days of completion of drilling of the well. Well Owner Information		Well Location		
Owner Name R. W. Tyson Producing		Latitude: 31 ° 32 ' 27" Longitude: 90 ° 44,42"		
Mailing Address: 675 N, Livi	ngston Rd	Method of Lat/Long (circle one): Conventional Survey,		
		-	GPS, Survey-grade GPS 5E	
		SE 14 SW 14 Sec 30	30 Twn 7N Rng 4E	
City J St	ate Zip Code	Distance Direction	Nearest Town	
Telephone No. ()		2,3 Miles N	of Quentin, MS	
	Well 1	Data		
Date well drilling started: 12 24 If flowing, method of flow regulation: Vi Static Water Level: 200 feet a Method of Measurement (circle one) Hole depth: 240 Well d Type of grout (circle one) Cement Casing length: 200 feet Cas	above or below (directe one) steel tape electric tape depth: 2 40 / Bentonite Mix sing diameter: 4 // green diameter: 4 // Setting depth: From	well drilling completed: describe) land surface	12/26/12 12/26/12 10_feet PVC PVC	
13/2000				
	•			
Top of lap pipe or reduction in casing:				
Logs run (circle all applicable): No log	run Electric Gamma Ra	y Density Sonic Neutron	Other:	
Name of organization running log(s):		James with all annitisch	le requirements of the Mississinni	
I certify that the well was drilled, cons	structed, and completed in	accordance with an applican	to reduitements of the transcorphi	
Department of Environmental Quality	y and/or the Mississippi D	epartment of Health regulatio	ns and state laws.	

Print Name of Water Well Contractor and License No.

JAN 0 3 2013


Signature of Water Wen Contractor

If well telescopes please sketch below and show depths.

Ground Level					

Description of Formations Encountered	From	То
Gravel	0	15
chalk	15	200
Coarse Sand	200	240
		_i

If more than one screen, show location of each on sketch

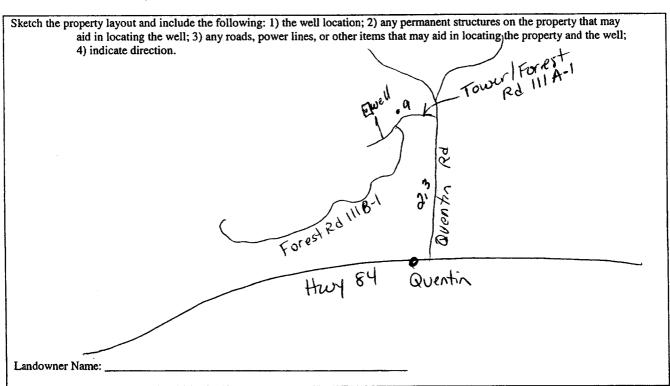







STATE WELL REPORT

Part 2

County: Franklin Pump Installer's Completion Report
Mississippi Department of Environmental Quality
Office of Land and Water Resources Permit #:

For (Office Use Only:
Aquifer:	
Well #:	E51
Elevation: _	

Driller: Gary Raybor > Date completed: 12/26/12	P.O. Box 10631 Jackson, MS 39289-0631 (601)961-5210 (601)354-6938 (fax)		Well #:	E51			
This report should be prepared by the pump installer in detail and filed with the Department within 30 days of the							
Well Owner Informat	installation of pump. Well Owner Information		Well Location				
Owner Name: R. W. Tyson	Producing	Latitude: Longitude:					
Mailing Address: 675 N. Livingston Rd		Method of Lat/Long (circle one): Conventional Survey,					
		USGS quad, Hand-held GPS, Survey-grade GPS					
Ridgeland, No State	SE 14 SW 14 Sec 30 Twn 7N Rng 4E						
City J State	Distance Direction Nearest Town 5E						
Telephone No. ()	2,3 Miles N of Quentin MS						
Pump Type Power Type							
Pump Type Circle one		Circle one					
Air Lift Jet 🤇	Submersible	Diesel Engine Gas	oline Engine	Natural Gas			
Bucket Piston	Turbine	Electric Motor Han	nd	Tractor PTO			
Centrifugal Rotary	Flowing Well	Windmill Oth	ner (specify):				
Other (specify):		Horse Power Rating of Motor: 5 H p					
Date Pump Installed: 12 26 12		Setting Depth:					
Rated Pump Capacity:	_Gallons Per Minute	Number of Stages:	11	_			
Pump Test Data		Method of	Measuring Water I	Level			
Date Well Tested: 12-26	12		Circle one				
Static Water Level (A): 200 Feet Below Land Surface		Air Line Electric Measuring Line Steel Tape					
Pumping Water Level (B):Feet	Other (specify):						
Drawdown [(B) – (A)]:Fee	For flowing well, measured shut in head:feet						
Test Pumping Rate:	Well yieldedGPM with a drawdown of						
Duration of Pump Test (minimum 4 hours)	feet afte	erho	ours of pumping				

I HEREBY CERTIFY that the above statements are true to the best of my knowledge. Print Name of Pump Installer and License No. (if applicable)

Signature of Pump Installer