

STATE WELL REPORT

Part 1

Driller's Log

Mississippi Department of Environmental Quality
Office of Land and Water Resources
P.O. Box 2309
Jackson, MS 39225-2309
(601)961-5555
(601)961-5228 (fax)

For Office Use Only:

Well #: E602
Aquifer: _____
E-Log #: _____

County: Franklin
Permit #: _____
Driller: Green Water Well
Date drilling completed: 7-12-18

State Law requires that this report be prepared by the license holder responsible for the work and filed with the Department at the above address within 30 days of completion of drilling of the well or borehole.

| Well Owner Information <small>(Landowner if borehole is not for a water well)</small> | Well or Borehole Location |
|--|---|
| Owner Name: <u>Charles Chapman</u> | Latitude: <u>31.5320</u> Longitude: <u>90.6753</u> <small>31-31-55 90-40-31</small> |
| Mailing Address: _____ <u>Lucienne Rd</u> | Method of Lat/Long (check one): Conventional Survey _____ |
| <u>McCall Creek MS</u> | USGS quad _____, Hand-held GPS <input checked="" type="checkbox"/> , Survey-grade GPS _____ |
| City _____ State _____ Zip Code _____ | <u>SW</u> <u>NE</u> <u>1/4</u> <u>SE</u> <u>1/4</u> , Sec <u>35</u> T. <u>07N</u> R. <u>5E</u> |
| Telephone No. (601) <u>835-5369</u> | <u>4</u> Miles <u>NO</u> of <u>McCall Creek</u> (Distance) (Direction) (Nearest Town) |


| Well / Borehole Data |
|--|
| Date drilling started: <u>7-11-18</u> Date drilling completed: <u>7-12-18</u> Hole depth: <u>150</u> Hole diameter: <u>7</u> |
| Location of the source of any surface water used for drilling: _____ |
| Method of dosing and volume of Chlorine used in drilling and development: <u>Mudpit + Gamel pack</u> |
| Logs run (check all applicable): <input type="checkbox"/> log run <input type="checkbox"/> Electric <input type="checkbox"/> Gamma Ray <input type="checkbox"/> Density <input type="checkbox"/> Sonic <input type="checkbox"/> Neutron Other: _____ |
| Name of organization running log(s): _____ |
| Purpose of borehole (check one): <input checked="" type="checkbox"/> Water Well <input type="checkbox"/> Geotechnical/Geological Investigation <input type="checkbox"/> Ground Source Heat Pump <input type="checkbox"/> Seismic Survey Other (describe) _____ |
| <i>If drilling is not related to water well construction, skip the remainder of this block</i> |
| Purpose of Well (check all applicable): <input checked="" type="checkbox"/> Home <input type="checkbox"/> Industrial <input type="checkbox"/> Public Supply <input type="checkbox"/> Irrigation <input type="checkbox"/> Fish Culture |
| Other (describe): _____ |
| If a flowing well, method of flow regulation: Valve _____ Other (describe) _____ |
| Static Water Level: <u>90</u> feet <input type="checkbox"/> above or <input checked="" type="checkbox"/> below land surface Date measured: <u>7-12-18</u> (check one) |
| Method of measurement (check one): <input type="checkbox"/> Steel tape <input checked="" type="checkbox"/> Electric tape <input type="checkbox"/> Air line <input type="checkbox"/> Other (describe): _____ |
| Well depth: <u>145</u> Well grouted to a depth of: <u>10</u> feet Type of grout (check one): <input type="checkbox"/> Neat Cement <input checked="" type="checkbox"/> Bentonite <input type="checkbox"/> Mix |
| Casing length: <u>125</u> feet Casing diameter: <u>4</u> inches Type of casing: <u>pvc</u> |
| Screen length: <u>20</u> feet Screen diameter: <u>4</u> inches Type of screen: <u>pvc</u> |
| Screen slot size: <u>.010</u> inches Setting depth: From <u>125</u> feet to <u>145</u> feet |
| Type of completion (check all applicable): <input checked="" type="checkbox"/> gravel packed <input type="checkbox"/> Underreamed <input type="checkbox"/> Open hole <input type="checkbox"/> Natural Development |
| Other (describe): _____ |
| Top of lap pipe or reduction in casing: _____ feet |
| <i>If telescoped or more than one screen, describe on next page</i> |

County: FRANKLIN
 Permit #: _____

For Office Use Only:
 Well #: E62

The sketch below only required for water wells
If well telescopes, show depths on sketch.


Description of formations encountered must be provided for all wells and boreholes, unless specifically exempted by regulations

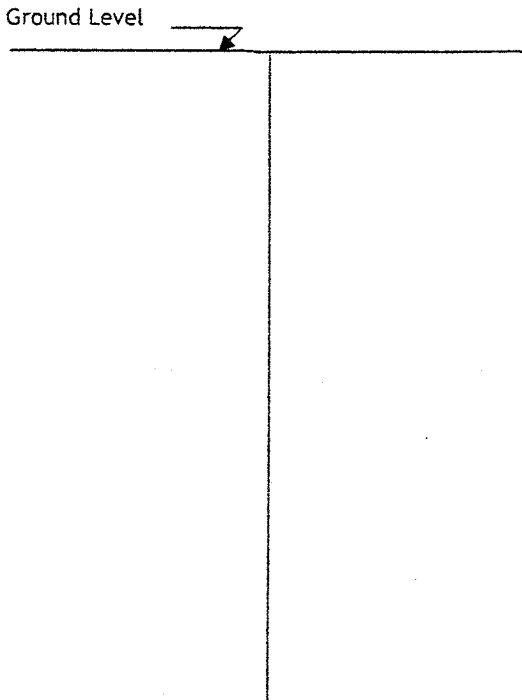

| Description of Formations Encountered | From (depth) Ground level | To (depth) |
|---------------------------------------|------------------------------|------------|
| Red Clay | 0 | 18 |
| Sand Sand | 18 | 30 |
| Gravel | 30 | 45 |
| Sand | 45 | 105 |
| Pea Gravel | 105 | 145 |
| Yellow Clay | 145 | 150 |
| | | |
| | | |
If more than one screen, show location of each on sketch

- Sketch the property layout and include the following:
- 1) the well location
 - 2) any permanent structures on the property that may aid in locating the well
 - 3) any roads, power lines, or other items that may aid in locating the property and the well
 - 4) north arrow

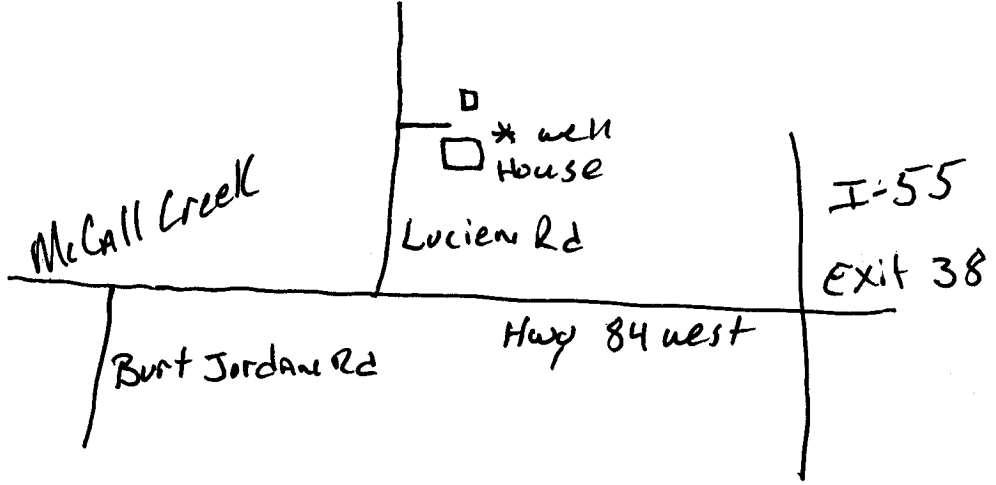

Landowner Name: Charles Chapman

I HEREBY CERTIFY that the well/borehole was drilled, constructed, and completed in accordance with all applicable requirements of the Mississippi Department of Environmental Quality and the Mississippi Department of Health regulations, if applicable, and state laws.

Michael W. KEES 7737 7-12-18
 Print Name of Responsible Licensee and License No. Date

Signature of Licensee

STATE WELL REPORT

Part 2

Pump Installer's Completion Report
 Mississippi Department of Environmental Quality
 Office of Land and Water Resources
 P.O. Box 2309
 Jackson, MS 39225-2309
 (601)961-5210
 (601) 360-0535 (fax)

County: Franklin
 Permit #: _____
 Driller: Green Water Well
 Date completed: 7-12-18
Copy information from block on Part 1

For Office Use Only:

Well #: E62
 Aquifer: _____

This part of the report must be completed by a licensed water well contractor or a licensed pump installer. A copy of Part 1 of the report must be attached and both parts filed with the Department at the above address within 30 days of well completion.

| Well Owner Information | | Well Location | |
|--|--|---|---------------------------|
| Owner Name: <u>Charles Chapman</u> | | <u>31-31-55</u> | <u>90-40-31</u> |
| Mailing Address: _____ <u>Lourens Rd.</u> | | Latitude: <u>31.5320</u> | Longitude: <u>90.6753</u> |
| <u>McCall Creek</u> MS | | Method of Lat/Long (check one): Conventional Survey _____, Hand-held GPS <input checked="" type="checkbox"/> , Survey-grade GPS _____ | |
| City _____ State _____ Zip Code _____ | | USGS quad _____, Sec <u>35</u> T <u>7N</u> R <u>5E</u> | |
| Telephone No. (w/01) <u>835-5369</u> | | <u>4</u> Miles <u>NE</u> of <u>McCall Creek</u> (Distance) (Direction) (Nearest Town) | |

Pump Type (check one)

Submersible Turbine Air Lift Centrifugal Flowing Well Jet Piston Rotary Other (describe): _____

Date Pump Installed: 7-12-18 Rated Pump Capacity: 10 Gallons Per Minute

Is This Pump (check one): New Repaired Replacement

Power Type (check one)

Electric Diesel Gasoline Natural Gas Tractor PTO Windmill Other (describe): _____

Horse Power Rating of Motor: 1 Setting Depth: 135 feet Number of Stages: 15

Pump Test Data for Non Flowing Well

Date Well Tested: 7-12-18 Duration of Pump Test (minimum 4 hours): 4 hours

Static Water Level (A): 90 Feet Below Land Surface Pumping Water Level (B): 46 Feet Below Land Surface

Drawdown [(B) - (A)]: 6 Feet Below Land Surface Test Pumping Rate: 12 Gallons Per Minute

Method of measurement (check one): Steel tape Electric tape Air line Other (describe): _____

Pump Test Data for Flowing Well

Measured shut in head: _____ feet.

Well yielded _____ GPM with a drawdown of _____ feet after _____ hours of pumping

Meter Installation

Meter Manufacturer: _____ Meter Serial Number: _____

Meter Model Number/Name: _____ Type of Meter: _____

Totalizer Register Unit and Multiplier Factor (AF x .001, gal x 1000, etc.): _____

Installation Date: _____ Meter installed by: _____

Is This Meter (check one): New Repaired Replacement

Important: By submitting the above information you are certifying that this meter was installed to manufacturer standards. For agricultural wells, a list of approved meters is on the MDEQ website.

I HEREBY CERTIFY that the above statements are true to the best of my knowledge.

Michael W. KERS 7737 7-12-18 Michael W. Kers
 Print Name of Pump Installer and License No. (if applicable) Date Signature of Pump Installer

RECEIVED
AUG 14 2018
BY OLWR