

MISSISSIPPI DEPARTMENT OF NATURAL RESOURCES
Bureau of Land and Water Resources

P.O. Box 10631
Jackson, Mississippi 39209
WATER WELL DRILLERS LOG

COUNTY WELL LOCATED Franklin	
WELL NUMBER 236174	CODED
PERMIT NUMBER 510	
NAME OF DRILLING FIRM Easley Water Wells	
DATE WELL COMPLETED 3-05-97	
Brookhaven, MS 39601	

NAME & MAILING ADDRESS OF LANDOWNER Thomas Lane			
WELL LOCATION:	SEC 34	TOWNSHIP 70^N_S	RANGE 5^E_W
DISTANCE	DIRECTION	NEAREST TOWN	
_____ Miles	_____ of _____		
OTHER LANDMARK			
WELL PURPOSE: Home, Irrigation, Municipal, Industrial, Fish Pond, etc.			

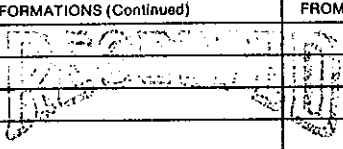
PUMP DATA		
PUMP TYPE (Circle One): <input checked="" type="checkbox"/> Submersible Turbine Jet Flowing Well, Other (Describe) _____		
POWER TYPE (Circle One): <input checked="" type="checkbox"/> Electric Tractor Diesel Gasoline Butane, Other (Describe) _____		
Pump Capacity (GPM)	No. of Stages	Setting Depth FT.
PUMP TEST		
Well yielded _____ GPM with a drawdown of _____ ft. after _____ hours of pumping		

WELL DATA		
Well Depth 180'	Casing Diameter (In.) 4"	Casing Length (Ft.) 160'
Type of Casing PVC	Hole Depth 200'	Depth to Static Water Level
TYPE OF COMPLETION: (Circle One or More): <input checked="" type="checkbox"/> Gravel Packed <input type="checkbox"/> Underreamed <input type="checkbox"/> Telescoped, <input checked="" type="checkbox"/> Natural Development <input type="checkbox"/> Open Hole <input type="checkbox"/> Other (Describe) _____		
Top of Lap Pipe or Reduction in Casing		
FEET IF TELESCOPED OR MORE THAN ONE SCREEN: USE BACK PAGE		

LOG DATA	
TYPE OF LOG RUN (Circle One): <input type="checkbox"/> No Log Run, <input type="checkbox"/> Electric, Gamma Ray, Density, Sonic, Neutron, Other (Describe) _____	
Name of Organization Running Log	

SCREEN DATA		
Diameter - Inches 4"	Length - Feet 20'	Slot Size - Inches 10
Screen Type PVC	Depth to Bottom - Feet 180'	

GEOLOGIC DATA (Office Use Only)			
Surface Elev.	Geologic Unit	Unit Thickness	Depth to Top
Subs. SWL	Date	Analysis	Aquifer Test
Driller's Remarks			

DESCRIPTION OF FORMATIONS ENCOUNTERED	FROM	TO	FORMATIONS (Continued)	FROM	TO
Clay	0	20	 AUG 19 1997 Dept. of Environmental Quality Office of Land & Water Resources		
Gravel	20	20			
Clay	70	160			
Sand	160	180			
Clay	180	200			
IF MORE SPACE IS NEEDED, USE BACK					