

FRANKLIN MISSISSIPPI BOARD OF WATER COMMISSIONERS

F.6
7-20-60

CODED

WATER WELL DRILLERS LOG


F-200

CODED

Date: July 20, 1960, Driller: Herring Jewiso Pt County: FRANKLIN
(Name)

(1) Owner of Land: <u>Condy Malone</u> (Name)	Description & Color of Materials Sand, Clay, Red Clay, Shell, etc.	Thick- ness Feet	Depth Feet
<u>POXIE, Miss.</u> (Address)	<u>Shell</u>	<u>270'</u>	<u>0</u>
(2) Location: <u>1/4</u> , <u>1/4</u> , Sec. <u>19</u> T <u>6</u> R <u>1</u>	<u>SAND</u>	<u>25'</u>	<u>270</u>
<u>1/2</u> miles <u>N.W.</u> , of <u>POXIE</u> (distance) (direction) (Nearest Town)			
(3) Topography: <u>✓</u> (Hilly) (Flat) (Level)			
(4) Purpose of Well: <u>Domestic</u> (Domestic Irrigation Municipal, Industrial, Other)			
Information upon completion of well:			
(1) Diameter <u>4 3/4</u> inches.			
(2) Total Depth <u>295</u> feet.			
(3) Water Level <u>85</u> feet below top of ground.			
(4) Cased to <u>290</u> , Size <u>2"</u>			
(5) Screen: Size <u>2"</u> , Length <u>5'</u>			
(6) Were any formations sealed against pollution? <u>no</u>			
If YES depth of formation _____			
Why _____			
Drillers Remarks: _____			

CODED

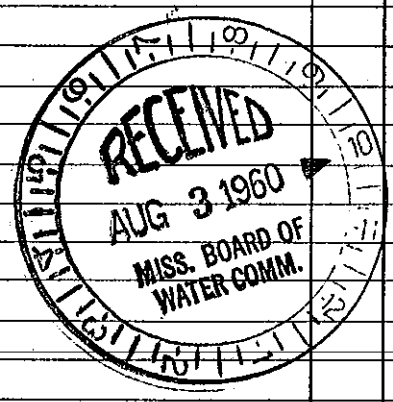

Well No.

(Use Back Side)

Mail this copy to Board of Water Commissioners 429 Miss. St. Jackson, Miss.