
Stote W	ell Report	
	art 1	For Office Use Only:
County: Mississippi Departmen	t of Environmental Quality	Aquifer:
Permit #: Office of Land a	nd Water Resources	Well #: <u>F - 24</u>
Driller GRENN WATER WELL &	Box 10631	
	1S 39289-0631 961-5210	L. S. Elevation:
(601)35	4-6938 (fax)	E-log #:
	Jullion in dotail and filed u	with the Department within
State Law requires that this report be prepared by the 30 days of completion of drilling of the well.		
Well Owner Information	Wel	l Location
Owner Name Nathan Laird	Latitude: 31 . 20 . 57	" Longitude: 91 • 5 · 06/
Mailing Address: 255 Terry Circle	AX CC Method of Lat/Long (circle o	ne): Conventional Survey,
	USGS quad, Nand-held	I GPS, Survey-grade GPS
Vidalia, La. 71373 City State Zip Code	<u>34/4 511/4 Sec_30</u>	<u>Twn 6N Rng / E</u>
City / State Zip Code Telephone No. $(601) 660 - 4377$	Distance Direction	Nearest Town
Well	Data	
Purpose of Well (circle one) Home Industrial Public Supply	Irrigation Fish Culture	Other:
Date well drilling started: <u>\$/24/05</u> Date	well drilling completed:	24/05
If flowing, method of flow regulation: Valve Other (
Static Water Level:feet above of below (circle one)	land surface Date measured	5/24/05
Method of Measurement (circle one) steel tape electric tap	e air line other:	•
Hole depth: <u>335</u> Well depth: <u>320</u>	Well grouted to a depth of	
Type of grout (circle one): Cement Bentonite Mix	-	· ·
Casing length: <u>300</u> feet Casing diameter: <u>4</u>	inches Type of casing:	PVC
Screen length: <u>20</u> feet Screen diameter: <u>4</u>	inches Type of screen:	PVC
Screen slot size: <u>, O/O</u> inches Setting depth: From	feet to	320_feet
Type of completion (circle all applicable): Gravel packed Under	erreamed Telescoped Ope	n hole Natural Development
Other (describe):		
Top of lap pipe or reduction in casing:feet. If	telescoped or more than one so	reen, describe on back of page
Logs run (circle all applicable): No log run Electric Gamma Ra	y Density Sonic Neutron	Other:
Name of organization running log(s): I certify that the well was drilled, constructed, and completed in	accordance with all analisch	e requirements of the Mississian
Department of Environmental Quality and/or the Mississippi D		
GRENN WATER WELL & SUPPLY, INC.	there are or research referention	
Brian McClendon, lic. no. 0-664	Brul	MCluni
Print Name of Water Well Contractor and License No.	Signature	of Water Well Contractor
		RECEIVED
		001 13 2005

BY: OLWR

æ

If well telescopes please sketch below and show depths.

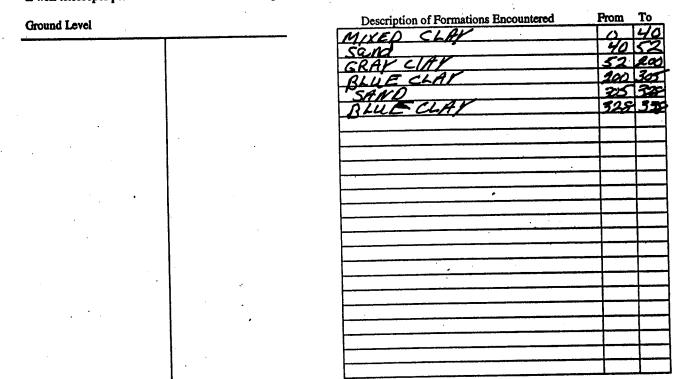

If more than one screen, show location of each on sketch

Sketch the property layout and include the following: 1) the well location; 2) any permanent structures on the property that may aid in locating the well; 3) any roads, power lines, or other items that may aid in locating the property and the well; Thouse 4) indicate direction. house drive 30 Landowner Name: Nathan haird

lendon

Signature of Water Well Contractor

Brian McClendon, lic. no. 0-664 GRENN WATER WELL & SUPPLY, INC.

RECEIVED 001 + 5 2005 BY: OLWE:

1=-24

		ELL REPORT		
County: Franklin	Pump Installer Mississippi Departme	Part 2 "s Completion Report ent of Environmental Quality	For Office Use Only: Aquifer:	
Driller: GRENN WATER WELL	& P.O.	and Water Resources Box 10631	Well #: <u>F-24</u> Elevation:	
Date completed: <u>8129/65</u>	Jackson,	MS 39289-0631 1)961-5210		
Date completed: <u>6</u> /2 9 /05		54-6938 (fax)		
This report should be prepare installation of pump.	ed by the pump installer in det	all and filed with the Departme	nt within 30 days of the	
Well Owner I	nformation		ell Location	
Owner Name: Nathan L.	aird	Latitude: 31°20 576	Longitude: <u>91 5 061</u> "	
Mailing Address: 255 Terr	y Circle	Method of Lat/Long (circle or	ne): Conventional Survey,	
	······	USGS quad, Han	d-held GPS) Survey-grade GPS	
Vidalia	La. 71373	<u>5W 14 5W 14 Sec_3</u>	O Twn <u>GN</u> Rng IE	
City	State Zip Code	Distance Direction	Nearest Town	
Telephone No. (601) 660 -	4377	2 Miles SW	of <u>Roxie</u>	
		1		
Pump 7 Circle			wer Type Fircle one	
Air Lift Jet	Submersible	Diesel Engine Gasoli	ne Engine Natural Gas	
Bucket Piston	Turbine	Electric Motor Hand	Tractor PTO	
Centrifugal Rotary	Flowing Well	Windmill Other	(specify):	
Other (specify):	-	Horse Power Rating of Motor		
Date Pump Installed: 8/29	105	Setting Depth: 140	feet	
Rated Pump Capacity: 16	Gallons Per Minute	Number of Stages:	<u>/</u>	
Pump Ter	st Data		easuring Water Level	
Date Well Tested: 8/29/	05	Circle one		
Static Water Level (A):	Feet Below Land Surface	Air Line Electric Measuring Line Steel Tape		
Pumping Water Level (B):	·	Other (specify):		
Drawdown [(B) – (A)]: 20	Feet Below Land Surface	For flowing well, measured si	hut in head:feet	
Test Pumping Rate: 19		Well yielded / 9	GPM with a drawdown of	
Duration of Pump Test (minimum 4		Zo feet after		
		· · · · · · · · · · · · · · · · · · ·		
I HEREBY CERTIFY that the above GRENN WATER WELL & SUL William Hardin, lic.	PPLY, INC. no. 0-717P	of my knowledge. William H.	ndin	
Print Name of Pump Installer and L	icense No. (if applicable)	Signature of Pump I	nstaller DECENN	
			OC 1 1 3 20	