

CODED

FRANKLIN

G4

MISSISSIPPI BOARD OF WATER COMMISSIONERS

6-7-66

WATER WELL DRILLERS LOG

Date: June 7, 1966, Driller: Chester Reeves County Franklin
(When well drilled) (Name) (Where well is located)

(1) Owner of Land:	Description & Color of Materials Sand, Clay, Red Clay, Shell, etc.	Thick- ness Feet	Depth Feet
<u>Gerald Canby</u> (Name) <u>RFD, Rapid</u> (Address)	<u>Clay</u> <u>with chaff</u>	<u>10</u>	<u>10</u>
(2) Location: <u>1/4</u> , <u>1/4</u> , Sec. <u>2762</u> <u>2</u> miles <u>East</u> of <u>Rapid</u> (distance) (direction) (Nearest Town)	<u>fine sand</u>	<u>35</u>	<u>45</u>
(3) Topography: <u>Hilly</u> (Hilly) (Flat) (Level)			
(4) Purpose of Well: <u>Domestic</u> (Domestic Irrigation Municipal, Industrial, Other)			

Information upon completion of well:

- (1) Diameter 4 inches.
- (2) Total Depth 90 feet.
- (3) Water Level 73 feet below top of ground.
- (4) Cased to Bottom Size 4"
- (5) Screen: Size 4", Length 6'
- (6) Were any formations sealed against pollution?
no

If YES depth of formation _____


Why _____

Drillers Remarks: new location

Yield in gpm: 15

Size pump: 1/2 HP Sub

Type power: Electric

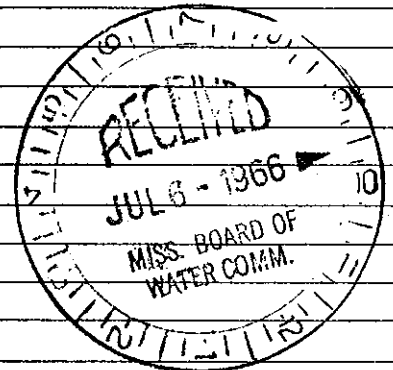

REEVES WELL & PUMP CO.
P. O. BOX 71 -:- PHONE 684-1451
McCOMB, MISS.

Send this copy to Board of Water Commissioners 429 Miss. St. Jackson, Miss.