

FRANKLIN

MISSISSIPPI BOARD OF WATER COMMISSIONERS

G5

CODED

WATER WELL DRILLERS LOG

~~G-300~~

9-7-60

Date: 9-7, 1960, Driller: Jerry Servisoff County Franklin
(Name)

(1) Owner of Land: <u>Monroe Hunt</u> (Name)	Description & Color of Materials Sand, Clay, Red Clay, Shell, etc.	Thick- ness Feet	Depth Feet
<u>meadville Miss.</u> (Address)	<u>Red Clay</u>	20'	20'
(2) Location: <u>8 1/4 SE 1/4, Sec. 13 T. 6 R. 2</u>	<u>Clay</u>	180'	200'
<u>7</u> miles <u>West</u> , of <u>Meadville</u> (distance) (direction) (Nearest Town)	<u>Sand</u>	3'	203'
(3) Topography: <input checked="" type="checkbox"/> (Flat) <input type="checkbox"/> (Hilly) <input type="checkbox"/> (Level)	<u>Clay</u>	200'	403'
(4) Purpose of Well: <u>Domestic</u> (Domestic Irrigation, Municipal, Industrial, Other)	<u>Sand</u>	27'	430'


Information upon completion of well:

- (1) Diameter 4 3/4 inches.
- (2) Total Depth 430 feet.
- (3) Water Level 200' feet below top of ground.
- (4) Cased to 425', Size 2"
- (5) Screen: Size 2", Length 5'
- (6) Were any formations sealed against pollution?
_____ yes, _____ no.

If YES depth of formation _____

Why _____

Drillers Remarks: _____

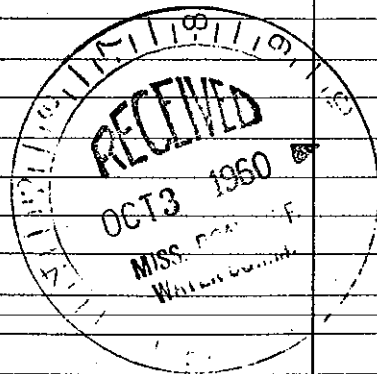

CODED

Well No.

(Use Back Side)

1 this copy to Board of Water Commissioners 429 Miss. St. Jackson, Miss