

FRANKLIN MISSISSIPPI BOARD OF WATER COMMISSIONERS

G6
11-5-62

CODED

WATER WELL DRILLERS LOG

CODED

Date: 1-5, 1964, Driller: Herring Perry Co. Franklin
(Name)

(1) Owner of Land: <u>C. C. Carbon</u> (Name)	Description & Color of Materials Sand, Clay, Red Clay, Shell, etc.	Thick- ness Feet	Depth Feet
<u>Rayje Miss</u> (Address)	<u>Sandy Sand</u>	<u>26</u> <u>40</u>	
(2) Location: <u>1/4</u> , <u>13</u> <u>T6 R2</u> , Sec. <u>13</u>			
<u>3</u> miles <u>E</u> , of <u>Boyle</u> (distance) (direction) (Nearest Town)			
(3) Topography: <u>?</u> (Hilly) (Flat) (Level)			
(4) Purpose of Well: <u>Domestic</u> (Domestic Irrigation Municipal, Industrial, Other)			

Information upon completion of well:


- (1) Diameter 4 3/4 inches.
- (2) Total Depth 301 feet.
- (3) Water Level 200 feet below top of ground.
- (4) Cased to 293, Size 2"
- (5) Screen: Size 2", Length 5'
- (6) Were any formations sealed against pollution?
_____ yes, ✓ no.

If YES depth of formation _____

Why _____

Drillers Remarks: _____

CODED

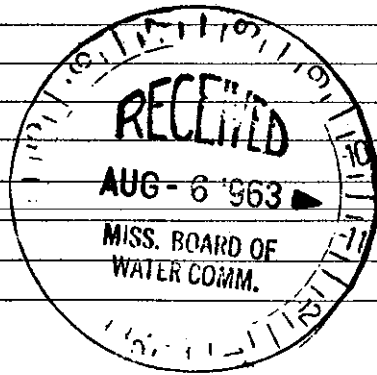

(Use Back Side)

Well No.