

STATE WELL REPORT

Part 1

Driller's Log

Mississippi Department of Environmental Quality
Office of Land and Water Resources
P.O. Box 2309
Jackson, MS 39225-2309
(601)961-5210
(601)360-0535 (fax)

For Office Use Only:

Well #: G 42
Aquifer:
E-Log #:

County: Franklin

Permit #:

Driller: Gary Rayborn

Date drilling completed: 8/26/13

State Law requires that this report be prepared by the license holder responsible for the work and filed with the Department at the above address within 30 days of completion of drilling of the well or borehole.

Well Owner Information (Landowner if borehole is not for a water well)
Owner Name: David Brown
Mailing Address: P.O. Box 204
Meadville MS 39653
City State Zip Code
Telephone No.
Well or Borehole Location
Latitude: 31°30'53" Longitude: 90°58'42"
Method of Lat/Long (check one): Conventional Survey
USGS quad, Hand-held GPS, Survey-grade GPS
1R 1/4 1R 1/4, Sec 3 T. 6N R. 2E
.6 Miles SE of Kirby, MS
(Distance) (Direction) (Nearest Town)

Well / Borehole Data
Date drilling started: 8/26/13 Date drilling completed: 8/26/13 Hole depth: 170 Hole diameter: 4"
Location of the source of any surface water used for drilling:
Method of dosing and volume of Chlorine used in drilling and development:
Logs run (circle all applicable): No log run Electric Gamma Ray Density Sonic Neutron Other:
Name of organization running log(s): N/A
Purpose of borehole (circle one): Water Well Geotechnical/Geological Investigation Ground Source Heat Pump
Seismic Survey Other (describe)

If drilling is not related to water well construction, skip the remainder of this block

Purpose of Well (circle all applicable): Home Industrial Public Supply Irrigation Fish Culture
Other (describe):
If a flowing well, method of flow regulation: Valve Other (describe)
Static Water Level: 40 feet [above or below] land surface Date measured: 8/26/13
Method of measurement (circle one): Steel tape Electric tape Air line Other (describe):
Well depth: 170 Well grouted to a depth of: 10 feet Type of grout (circle one): Neat Cement Bentonite Mix
Casing length: 150 feet Casing diameter: 4 inches Type of casing: PVC
Screen length: 20 feet Screen diameter: 4 inches Type of screen: PVC
Screen slot size: .010 inches Setting depth: From 150 feet to 170 feet
Type of completion (circle all applicable): Gravel packed Underreamed Open hole Natural Development
Other (describe):
Top of lap pipe or reduction in casing: feet

If telescoped or more than one screen, describe on next page

RECEIVED
SEP 24 2013


BY: OLWR

Print Name of Responsible Licensee and License No. Date Signature of Licensee

Gary Rayborn 0-60 9/30/13

I HEREBY CERTIFY that the well/borehole was drilled, constructed, completed in accordance with all applicable requirements of the Mississippi Department of Environmental Quality and the Mississippi Department of Health regulations, if applicable, and state laws.


Landowner Name:

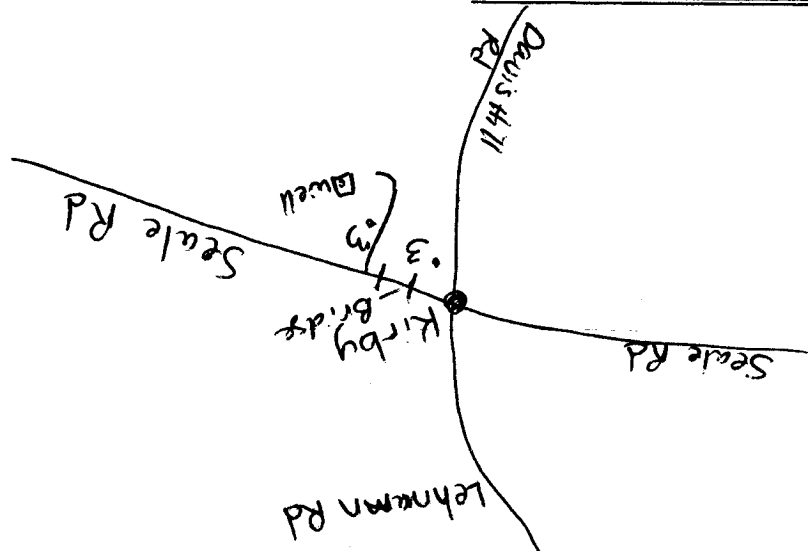

1) the well location
2) any permanent structures on the property that may aid in locating the well
3) any roads, power lines, or other items that may aid in locating the property and the well
4) north arrow

Sketch the property layout and include the following:

If more than one screen, show location of each on sketch

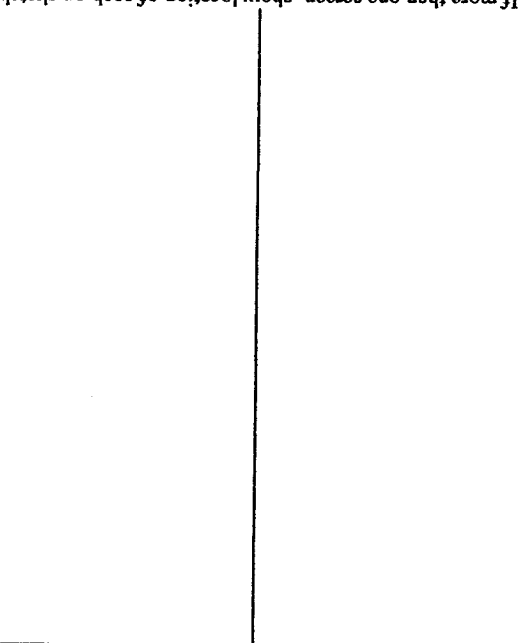

Ground Level

If well telescopes, show depths on sketch.

The sketch below only required for water wells

County: _____
Permit #: _____

Description of Formations Encountered	From (depth)	To (depth)
Chalk	10	10
Sand	10	20
Chalk	20	140
Coarse Sand	140	170

Description of formations encountered must be provided for all wells and boreholes, unless specifically exempted by regulations

For Office Use Only:
Well #: _____

STATE WELL REPORT

Part 2

Pump Installer's Completion Report
 Mississippi Department of Environmental Quality
 Office of Land and Water Resources
 P.O. Box 2309
 Jackson, MS 39225-2309
 (601)961-5210
 (601) 360-0535 (fax)

County: Franklin
 Permit #: _____
 Driller: Gary Rayborn
 Date completed: 8/26/13
Copy information from block on Part 1

For Office Use Only:

Well #: 642
 Aquifer: _____

This part of the report must be completed by a licensed water well contractor or a licensed pump installer. A copy of Part 1 of the report must be attached and both parts filed with the Department at the above address within 30 days of well completion.

Well Owner Information	Well Location
Owner Name: <u>David Brown</u>	Latitude: <u>31°30'53"</u> Longitude: <u>90° 58' 42"</u>
Mailing Address: <u>P.O. Box 204</u>	Method of Lat/Long (check one): Conventional Survey _____, USGS quad _____, Hand-held GPS _____, Survey-grade GPS _____
<u>Meadville MS 39653</u>	_____ 1/4 _____ 1/4, Sec <u>3</u> T <u>6N</u> R <u>2E</u>
City State Zip Code	<u>.6</u> Miles <u>SE</u> of <u>Kirby</u>
Telephone No. () _____	(Distance) (Direction) (Nearest Town)

Pump Type (circle one)

Submersible Turbine Air Lift Centrifugal Flowing Well Jet Piston Rotary Other (describe): _____

Date Pump Installed: 8/26/13 Rated Pump Capacity: 10 Gallons Per Minute

Is This Pump (circle one): New Repaired Replacement

Power Type (circle one)

Electric Diesel Gasoline Natural Gas Tractor PTO Windmill Other (describe): _____

Horse Power Rating of Motor: 1-HP Setting Depth: 100 feet Number of Stages: 11

Pump Test Data for Non Flowing Well

Date Well Tested: 8/26/13 Duration of Pump Test (minimum 4 hours): _____ hours

Static Water Level (A): 40 Feet Below Land Surface Pumping Water Level (B): _____ Feet Below Land Surface

Drawdown [(B) - (A)]: _____ Feet Below Land Surface Test Pumping Rate: 10 Gallons Per Minute

Method of measurement (circle one): Steel tape Electric tape Air line Other (describe): _____

Pump Test Data for Flowing Well

Measured shut in head: _____ feet.

Well yielded _____ GPM with a drawdown of _____ feet after _____ hours of pumping

Meter Installation

Meter Manufacturer: _____ Meter Serial Number: _____

Meter Model Number/Name: _____ Type of Meter: _____

Totalizer Register Unit and Multiplier Factor (AF x .001, gal x 1000, etc): _____

Installation Date: _____ Meter Installed by: _____

Is This Meter (circle one): New Repaired Replacement

Important: By submitting the above information you are certifying that this meter was installed to manufacturer standards. For agricultural wells, a list of approved meters is on the MDEQ website.

I HEREBY CERTIFY that the above statements are true to the best of my knowledge.

Gary Rayborn D-60 9/20/13
 Print Name of Pump Installer and License No. (if applicable) Date Signature of Pump Installer

The first part of the document discusses the importance of maintaining accurate records of all transactions. It emphasizes that every entry should be supported by a valid receipt or invoice. This ensures transparency and allows for easy verification of the data.

Furthermore, it is noted that the records should be kept in a secure and accessible format. Digital storage is preferred over physical files, as it reduces the risk of loss and makes it easier to search through the data.

The second section covers the process of reconciling accounts. This involves comparing the internal records with the bank statements to identify any discrepancies. If there are differences, they should be investigated immediately to determine the cause.

Regular reconciliation is essential to prevent errors from accumulating and to ensure that the financial statements are accurate. It also helps in identifying any unauthorized transactions or fraud.

The third part of the document focuses on the preparation of financial statements. It outlines the steps required to calculate the net income, assets, and liabilities. Each calculation should be clearly documented, showing the formulas used and the data sources.

It is also stressed that the statements should be prepared on a regular basis, typically at the end of each month or quarter. This allows for timely analysis of the company's financial performance and helps in making informed decisions.

Additionally, the document mentions the importance of reviewing the statements with management and other stakeholders. This ensures that everyone is aware of the current financial position and can discuss any necessary adjustments or strategies.

Finally, the document concludes by highlighting the overall goal of financial management: to provide a clear and accurate picture of the company's financial health. This is crucial for long-term success and sustainability.

The final section discusses the role of technology in modern accounting. It notes that software solutions have significantly streamlined the accounting process, reducing the time and effort required for data entry and calculations.

However, it also warns against over-reliance on technology. While software can handle many tasks, it is still important for accountants to understand the underlying principles and to perform regular manual checks to ensure accuracy.

The document also touches upon the importance of staying updated with the latest accounting standards and regulations. This is particularly true in light of the frequent changes in tax laws and financial reporting requirements.

In conclusion, effective financial management requires a combination of accurate record-keeping, regular reconciliation, timely preparation of financial statements, and the use of appropriate technology. By following these guidelines, businesses can ensure their financial health and make strategic decisions for the future.