

FRANKLIN MISSISSIPPI BOARD OF WATER COMMISSIONERS

H 6
8-6-60

CODED

WATER WELL DRILLERS LOG

~~H 302~~

Date: 8-6, 1960, Driller: Warren Dennis, Inc. County Franklin
(Name)

(1) Owner of Land: Alfred Wigninton
(Name)
Meridville, Miss.
(Address)

(2) Location: 1/4, 1/4, Sec. 34 T. 6 R. 3,
1 miles South, of Meridville,
(distance) (direction) (Nearest Town)

(3) Topography: Hilly
(Hilly) (Flat) (Level)

(4) Purpose of Well: Domestic
(Domestic, Irrigation, Municipal, Industrial, Other)

Description & Color of Materials Sand, Clay, Red Clay, Shell, etc.	Thick-ness Feet	Depth Feet
<u>Clay</u>	<u>70'</u>	<u>70'</u>
<u>Sand</u>	<u>10'</u>	<u>80'</u>
<u>Clay</u>	<u>80'</u>	<u>160'</u>
<u>Sand</u>	<u>78'</u>	<u>238'</u>

CODED

Information upon completion of well:

(1) Diameter 4 3/4 inches.

(2) Total Depth 238' feet.

(3) Water Level 70' feet below top of ground.

(4) Cased to 233', Size 2".


(5) Screen: Size 2", Length 5'.

(6) Were any formations sealed against pollution?
no, no.

If YES depth of formation _____

Why _____

Drillers Remarks: _____

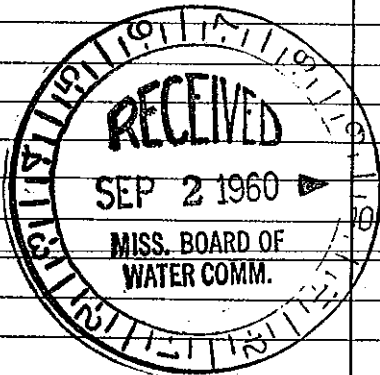

Well No. _____

(Use Back Side)

Mail this copy to Board of Water Commissioners 429 Miss. St. Jackson, Miss.