

FRANKLIN MISSISSIPPI BOARD OF WATER COMMISSIONERS

H9

CODED

WATER WELL

CODED

H-305

7-22-60

Date: July 22, 1960, Driller: Herring Sewell No. 103 County Franklin

(Name)


(1) Owner of Land: John Mullins  
 (Name)  
Meadville, Miss.  
 (Address)  
 (2) Location: 1/4, 1/4, Sec. 29 6<sup>N</sup> 3<sup>E</sup>  
1 miles N.W. of Meadville.  
 (distance) (direction) (Nearest Town)  
 (3) Topography:  (Hilly)  (Flat)  (Level)  
 (4) Purpose of Well: Domestic  
 (Domestic Irrigation, Municipal, Industrial, Other)

Description & Color of Materials Sand, Clay, Red Clay, Shell, etc.	Thick- ness Feet	Depth Feet
<u>Red Clay</u>	<u>10</u>	<u>0</u>
<u>Sh. Gravel Pea</u>	<u>30'</u>	<u>10</u>
<u>Shell</u>	<u>30'</u>	<u>40</u>
<u>SAND</u>	<u>30'</u>	<u>70</u>

Information upon completion of well:

(1) Diameter 4 3/4 inches.  
 (2) Total Depth 100 feet.  
 (3) Water Level 5 1/2 feet below top of ground.  
 (4) Cased to 95', Size 2"  
 (5) Screen: Size 2", Length 5'  
 (6) Were any formations sealed against pollution?  
 \_\_\_\_\_ yes,  no.  
 If YES depth of formation \_\_\_\_\_  
 Why \_\_\_\_\_  
 Drillers Remarks: \_\_\_\_\_

CODED

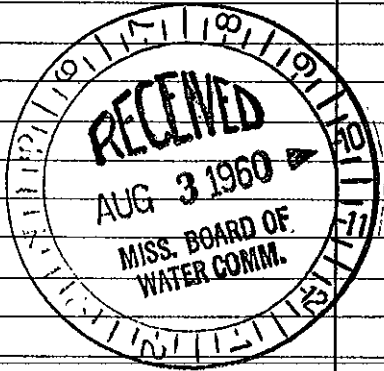

(Use Back Side)

Well No.

Mail this copy to Board of Water Commissioners 429 Miss. St. Jackson, Miss.