

FRANKLIN MISSISSIPPI BOARD OF WATER COMMISSIONERS

H 11

12-7-65

CODED

WATER WELL DRILLERS LOG

Date: 12-7, 1965, Driller: Chester Rene County Franklin  
(Name)

(1) Owner of Land: Curtis Durr  
(Name)  
RFD Katie -  
(Address)

(2) Location: 1/4, 1/4, Sec. 6 T6 R3  
7 miles west Medulla  
(distance) (direction) (Nearest Town)

(3) Topography: Hilly  
(Hilly) (Flat) (Level)

(4) Purpose of Well: Domestic  
(Domestic Irrigation, Municipal, Industrial, Other)

Description & Color of Materials Sand, Clay, Red Clay, Shell, etc.	Thick- ness Feet	Depth Feet
Top Clay	12	12
Yellow sand	118	130
Coarse sand	18	148

Information upon completion of well:

(1) Diameter: 4 inches.

(2) Total Depth: 148 feet.

(3) Water Level: 132 feet below top of ground.

(4) Cased to: Bottom, Size 4"


(5) Screen: Size 4", Length 6'

(6) Were any formations sealed against pollution?  
yes,  no.

If YES depth of formation \_\_\_\_\_

Why \_\_\_\_\_

Drillers Remarks: no previous well

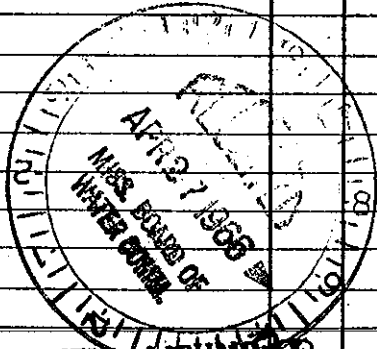

BEEVES WELLS & PUMP CO.  
P. O. BOX 71 - PHONE 684-1431  
McCOMB, MISS.

Well No.

(Use Back Side)

Mail this copy to Board of Water Commissioners 429 Miss. St. Jackson, Miss.