

CODED

Franklin
H14
6-67

MISSISSIPPI
BOARD OF WATER COMMISSIONERS
416 North State Street
Jackson, Mississippi 39201

WATER WELL DRILLERS LOG

January 1967 Keenwell Pump Co Franklin
date well completed firm name county well located

LANDOWNER: Ed Drum
RFD
Kosciusko, Miss
(mailing address)

WELL LOCATION:
sec. 5 T. 6 N R. 3 E
4 miles N.W. - Mendenhall
(distance) (direction) (nearest town)


WELL PURPOSE: Domestic
(home, irrigation, municipal, industrial)

WELL COMPLETION DATA:

- (1) diameter (inches) 4 1/2
- (2) total depth (feet) 117
- (3) static water level (feet) 90 below top of ground.
- (4) casing Plastic Bottom
(material) (depth)
(size) if telescope see back.
- (5) screen 6 1/2
(length) (depth to top)
4" Plastic
(size) (material)
- (6) pump 1 HP
other pump (type power) (gpm)
- (7) electric log (yes or no)
- (organization running log)
- (8) how well bottom plugged? plugged

description of formations encountered	from	to
yellow clay	0	30
yellow sand	30	80
mixed clay and gravel	80	100
fine sand	100	110
coarse sand with small amount of pea gravel	110	117

CODED

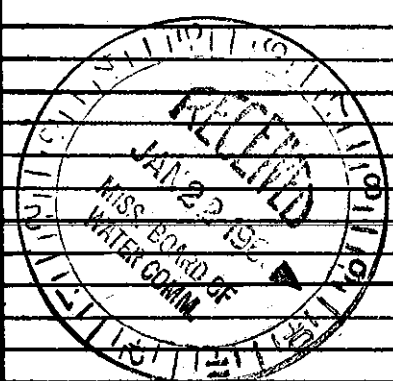

DRILLERS REMARKS: good well no problems