

CODED

MISSISSIPPI  
BOARD OF WATER COMMISSIONERS  
416 North State Street  
Jackson, Mississippi 39201

WATER WELL DRILLERS LOG

Franklin  
H15  
12-67

12-29 1967 L. Fitzgerald Water Well Franklin  
date well completed firm name county well located

LANDOWNER: Joe Brown  
Meadville RT MISS  
(mailing address)

description of formations encountered	from	to
top soil & clay	0	12
sand	12	60
sand & gravel	60	70
chalk hard	70	150
sand & gravel	150	166

WELL LOCATION:  
sec 32 T 6 N 3 E  
3 miles (distance) SE (direction) of Meadville (nearest town)

WELL PURPOSE: home  
(home, irrigation, municipal, industrial)

WELL COMPLETION DATA:

(1) diameter (inches) 4

(2) total depth (feet) 166

(3) static water level (feet) 90 below above top of ground.

(4) casing plastic 160 (material) (depth)  
4 if telescope see back. (size)


(5) screen 6' 160 (length) (depth to top)  
4 sch 90 (size) (material)

(6) pump 1/2 sub 10 (HP) (yield gpm)  
elec (type power)

(7) electric log NO (yes or no)  
(organization running log)

(8) how well bottom plugged wood peg

T+R location is  
about 1 mi. SE of  
Meadville.  
RM

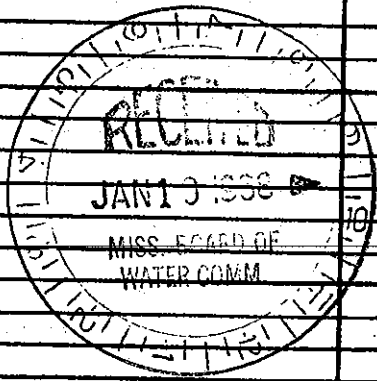

DRILLERS REMARKS: