

CODED

Franklin  
H16  
12-67

MISSISSIPPI  
BOARD OF WATER COMMISSIONERS  
416 North State Street  
Jackson, Mississippi 39201

WATER WELL DRILLERS LOG

12-27-1967 date well completed  
Fitzgerald Water Well firm name  
Franklin county well located

LANDOWNER: Pete Alford  
Meadville Miss Rt  
(mailing address)

| description of formations encountered | from | to  |
|---------------------------------------|------|-----|
| top soil / clay                       | 0    | 25  |
| Red Sand                              | 25   | 65  |
| Chalk                                 | 65   | 80  |
| Sand & gravel                         | 80   | 106 |
| Chalk                                 | 106  | 153 |
| Sand & gravel                         | 153  | 210 |

WELL LOCATION:  
sec. 1 T. 6 N. R. 3 E  
4 miles N of Meadville  
(distance) (direction) (nearest town)

WELL PURPOSE:  
(home, irrigation, municipal, industrial)

WELL COMPLETION DATA:

(1) diameter (inches) 4

(2) total depth (feet) 209

(3) static water level (feet) 170 below / above top of ground.

(4) casing plastic 162  
(material) (depth)  
4 if telescope see back.  
(size)


(5) screen 8' 162  
(length) (depth to top)  
4 plastic  
(size) (material)

(6) pump Spec  
(HP) (yield gpm)  
(type power)

(7) electric log No  
(yes or no)

(8) how well bottom plugged Wood peg

CODED

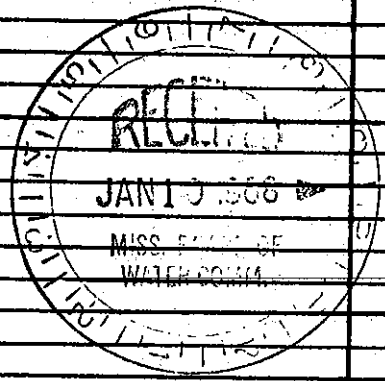

DRILLERS REMARKS: