

FRANKLIN MISSISSIPPI BOARD OF WATER COMMISSIONERS

H2O  
6-6-65

CODED

WATER WELL DRILLERS LOG

CODED

Date: 6-6, 1965, Driller: Chester Kelner, County: Franklin

(1) Owner of Land	Description & Color of Materials	Thick-ness Feet	Depth Feet
Harvey Prather (Name) RFD Meadville (Address)	Top Clay Yellow sand Blue clay Sand - coarse	15 75 35 15	15 90 125 140
(2) Location: 1/4, 1/4, Sec. 6 T6 R3 5 miles West of Meadville (distance) (direction) (Nearest Town)			
(3) Topography: Hilly (Hilly) (Flat) (Level)			
(4) Purpose of Well: Domestic (Domestic Irrigation Municipal, Industrial, Other)			

Information upon completion of well:

(1) Diameter: 4 inches.

(2) Total Depth: 140 feet.

(3) Water Level: 105 feet below top of ground.

(4) Cased to: Bottom, Size 4

(5) Screen: Size 4", Length 7'


(6) Were any formations sealed against pollution?  
 yes,  no.

If YES depth of formation \_\_\_\_\_

Why \_\_\_\_\_

Drillers Remarks: New House -

CODED

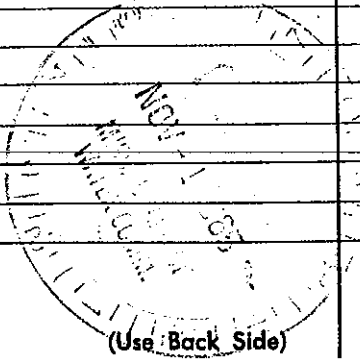

Well No.