

MISSISSIPPI DEPARTMENT OF NATURAL RESOURCES

Bureau of Land and Water Resources

P.O. Box 10631
Jackson, Mississippi 39209
WATER WELL DRILLERS LOG

COUNTY WELL LOCATED Franklin	
WELL NUMBER H 7014	CODED
DATE WELL COMPLETED 5-31-88	

PERMIT NUMBER
RAYBORN DRILLING, INC.
Rt 5 Box 98 Natchez Ms 39120

NAME & MAILING ADDRESS OF LANDOWNER Margaret Whittington		
505 South Commerce		
Natchez Ms 39120		
WELL LOCATION: SEC	TOWNSHIP	RANGE
40	6	3
	N	E
	S	W
DISTANCE	DIRECTION	NEAREST TOWN
3 Miles	SW	of Meadville
OTHER LANDMARK		
WELL PURPOSE: Home, Irrigation, Municipal, Industrial, Fish Pond, etc. Home		

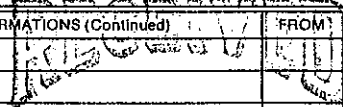
PUMP DATA		
PUMP TYPE (Circle One): <input checked="" type="radio"/> Submersible, <input type="radio"/> Turbine, <input type="radio"/> Jet <input type="radio"/> Flowing Well, Other (Describe)		
POWER TYPE (Circle One): <input checked="" type="radio"/> Electric, <input type="radio"/> Tractor, <input type="radio"/> Diesel, <input type="radio"/> Gasoline, <input type="radio"/> Butane, Other (Describe)		
Pump Capacity (GPM)	No. of Stages	Setting Depth
10	12	100 FT.
PUMP TEST		
Well yielded 10 GPM with a drawdown of 8 ft. after 12 hours of pumping		

WELL DATA		
Well Depth	Casing Diameter (In.)	Casing Length (Ft.)
120'	4"	110'
Type of Casing	Hole Depth	Depth to Static Water Level
Sch 40 PVC	120'	20'
TYPE OF COMPLETION: (Circle One or More): <input checked="" type="checkbox"/> Gravel Packed, <input type="checkbox"/> Underreamed, <input type="checkbox"/> Telescoped, <input checked="" type="checkbox"/> Natural Development, <input type="checkbox"/> Open Hole, <input type="checkbox"/> Other (Describe)		
Top of Lap Pipe or Reduction in Casing		
FEET IF TELESCOPED OR MORE THAN ONE SCREEN: USE BACK PAGE		

LOG DATA	
TYPE OF LOG RUN (Circle One): <input type="radio"/> Electric, <input type="radio"/> Gamma Ray, <input type="radio"/> Density, <input type="radio"/> Sonic, <input checked="" type="radio"/> Neutron, Other (Describe)	
Name of Organization Running Log	

SCREEN DATA		
Diameter - Inches	Length - Feet	Slot Size - Inches
4"	10'	.012
Screen Type	Depth to Bottom - Feet	
Sch 40 Slotted PVC	120'	

GEOLOGIC DATA (Office Use Only)			
Surface Elev.	Geologic Unit	Unit Thickness	Depth to Top
Subs. SWL	Date	Analysis	Aquifer Test
Driller's Remarks			

DESCRIPTION OF FORMATIONS ENCOUNTERED	FROM	TO	FORMATIONS (Continued)	FROM	TO
Top Soil	0	15	 JUL 08 1988 Department of Natural Resources Bureau of Land & Water Resources		
Gravel	15	25			
sand	25	120			

IF MORE SPACE IS NEEDED, USE BACK