

FRANKLIN MISSISSIPPI BOARD OF WATER COMMISSIONERS

J3
9-5-63

CODED SW 09649


32

WATER WELL DRILLERS LOG **CODED**

Date: 9-5-, 1963, Driller: Layne-Central Co. County Franklin
(Name)

(1) Owner of Land: <u>Town of Bude</u> (Name)	Description & Color of Materials Sand, Clay, Red Clay, Shell, etc.	Thick- ness Feet	Depth Feet
<u>Bude, Mississippi</u> (Address)	red sand & gravel	10	0
(2) Location: <u>1/4, 1/4, Sec. 19 T. 6 R. 4</u>	clay	10	20
<u>_____</u> miles, of <u>_____</u> (distance) (direction) (Nearest Town)	sand & stks clay	22	42
(3) Topography: _____ (Hilly) (Flat) (Level)	clay	23	65
(4) Purpose of Well: <u>Municipal</u> (Domestic Irrigation Municipal, Industrial, Other)	blue clay	80	145
Information upon completion of well:	clay stks sand	33	178
(1) Diameter <u>10</u> inches.	sand	68	246
(2) Total Depth <u>237</u> feet.	sandy clay	22	268
(3) Water Level <u>84'</u> feet below top of ground.	clay	91	359
(4) Cased to <u>184'</u> , Size <u>10"</u>			
(5) Screen: Size <u>8"</u> , Length <u>53'</u>			
(6) Were any formations sealed against pollution? <u>X</u> yes, _____ no.			
If YES depth of formation <u>184'</u>			
Why _____ required			
Drillers Remarks: _____			

CODED

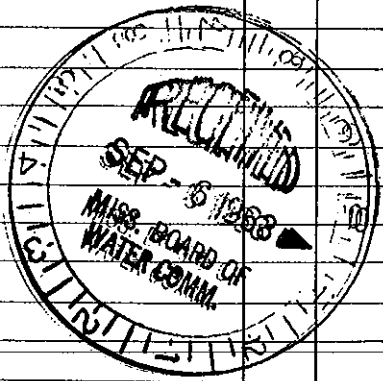

Well No. _____

(Use Back Side)

Mail this copy to Board of Water Commissioners 429 Miss. St. Jackson, M