

FRANKLIN MISSISSIPPI BOARD OF WATER COMMISSIONERS

JA

CODED

WATER WELL DRILLERS LOG


J-300

8-26-60

Date: 8-26, 1960, Driller: Herring Leusselt County Franklin
(Name)

(1) Owner of Land:	Description & Color of Materials Sand, Clay, Red Clay, Shell, etc.	Thick- ness Feet	Depth Feet
(Name) <u>Wanna Porter</u> <u>Rt. 3 - Mendville, Miss</u> <small>(Address)</small>	<u>Red Clay</u>	<u>15'</u>	<u>15'</u>
(2) Location: <u>SE 1/4, SW 1/4, Sec. 36 T. 6 R. 4</u> <u>8 miles East of Mendville</u> <small>(distance) (direction) (Nearest Town)</small>	<u>Clay</u> <u>Sand</u> <u>Clay</u> <u>Sand</u>	<u>125'</u> <u>5'</u> <u>10'</u> <u>45'</u>	<u>150'</u> <u>155'</u> <u>165'</u> <u>210'</u>
(3) Topography: <u>Flat</u> <small>(Hilly) (Flat) (Level)</small>			
(4) Purpose of Well: <u>Domestic</u> <small>(Domestic Irrigation Municipal, Industrial, Other)</small>			
Information upon completion of well:			
(1) Diameter <u>7 3/4"</u> inches.			
(2) Total Depth <u>210'</u> feet.			
(3) Water Level <u>160'</u> feet below top of ground.			
(4) Cased to <u>205'</u> , Size <u>2"</u>			
(5) Screen: Size <u>2"</u> , Length <u>5'</u>			
(6) Were any formations sealed against pollution? <u>yes</u> , <input checked="" type="checkbox"/> <u>no</u> .			
If YES depth of formation _____			
Why _____			
Drillers Remarks: _____			

CODED

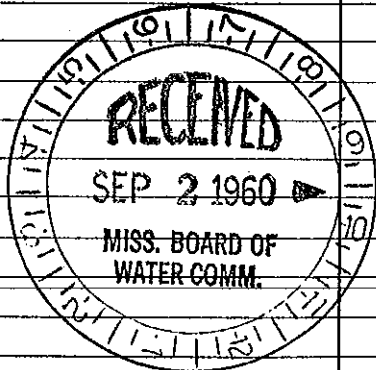

Well No.

(Use Back Side)

Mail this copy to Board of Water Commissioners 429 Miss. St. Jackson, Miss.