

FRANKLIN
J6

MISSISSIPPI BOARD OF WATER COMMISSIONERS

8-29-63

WATER WELL DRILLERS LOG

CODED

Date: 8-29, 1963, Driller: Chester Reeves County Franklin
(Name)

(1) Owner of Land: Mrs. H. W. Byrd
(Name)
Eddiceton, Miss
(Address)

(2) Location: 1/4, 1/4, Sec. 10 T6R4,
Eddiceton, Miss
(Township) (Range) (Section) (County) (Nearest Town)


(3) Topography: Flat
(Hilly) (Flat) (Level)

(4) Purpose of Well: Domestic
(Domestic Irrigation
Municipal, Industrial, Other)

Description & Color of Materials Sand, Clay, Red Clay, Shell, etc.	Thick- ness Feet	Dept Fee
Black surface soil	10	10
Sandy soil	10	20
Fine sand & white chalk	30	50
Coarse white sand	12	62

Information upon completion of well:

- (1) Diameter: 4 inches.
- (2) Total Depth: 62 feet.
- (3) Water Level: 9 feet below top of ground.
- (4) Cased to: Bottom, size 4"
- (5) Screen: Size 4", Length 5'
- (6) Were any formations sealed against pollution?
yes, no.

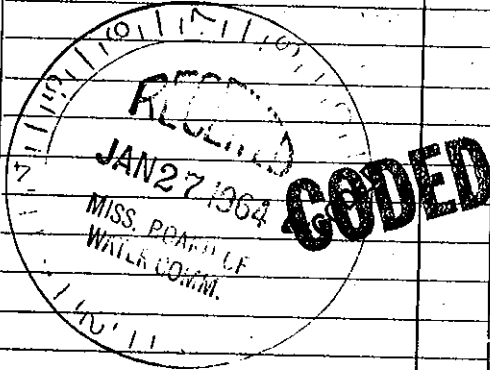

If YES depth of formation _____

Why _____

Drillers Remarks: set well
not adequate

REEVES WELL & PUMP CO.
P. O. BOX 71 - PHONE 684-1451
McCOMB, MISS.

Retain this copy for your office files.

(Use Back Side)

Well No.