

FRANKLIN MISSISSIPPI BOARD OF WATER COMMISSIONERS

J7

CODED

WATER WELL DRILLERS LOG

7-27-64

Date: 7-27, 1964, Driller: Chester Deere County Franklin

(Name)

(1) Owner of Land:	Description & Color of Materials Sand, Clay, Red Clay, Shell, etc.	Thick- ness Feet	Depth Feet
P. R. Davis (Name) Eddiceton, Miss (Address)	Hard red clay sand & gravel clay clayey gravel sand & gravel	12 8 30 22 14	12 20 50 70 84
(2) Location: 1/4 - 1/4, Sec. 2 T6 R4 in Eddiceton (distance) (direction) (Nearest Town)			
(3) Topography: Flat (Hilly) (Flat) (Level)			
(4) Purpose of Well: Domestic (Domestic Irrigation Municipal, Industrial, Other)			

Information upon completion of well:


- (1) Diameter 4" inches.
- (2) Total Depth 84 feet.
- (3) Water Level 16 feet below top of ground.
- (4) Cased to Bottom 4" size.
- (5) Screen: Size 4", Length 6'
- (6) Were any formations sealed against pollution?
_____ yes, _____ no.

If YES depth of formation _____

Why _____

Drillers Remarks: old well
Bad

CODED

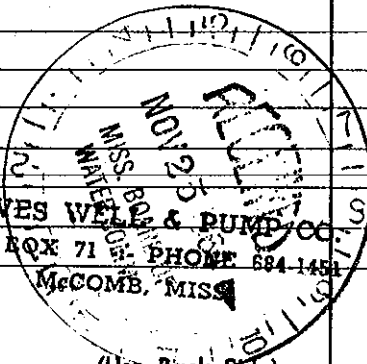

(Use Back Side)

Well No.

Mail this copy to Board of Water Commissioners 429 Miss. St. Jackson, Miss