

FRANKLIN MISSISSIPPI BOARD OF WATER COMMISSIONERS

J8

8-31-64

CODED

WATER WELL DRILLERS LOG

Date: 8-31, 1964, Driller: Chester Reeves County Franklin

(Name)

(1) Owner of land: Ryton Soboleff
(Name)

Eddiceton
(Address)

Description & Color of Materials
Sand, Clay, Red Clay, Shell, etc.

Thick-
ness
Feet

Depth
Feet

Top soil
white sand
fine

5

5

90

95

(2) Location: 1/4, 1/4, Sec. 7 T6R4

1 miles north of Eddiceton
(distance) (direction) (Nearest Town)

(3) Topography: Flat
(Hilly) (Flat) (Level)

(4) Purpose of Well: Domestic
(Domestic Irrigation
Municipal, Industrial, Other)

Information upon completion of well:

(1) Diameter 4 inches.

(2) Total Depth 95 feet.

(3) Water Level 25 feet below top of ground.

(4) Cased to bottom size.

(5) Screen: Size 4", Length 7'


(6) Were any formations sealed against pollution?
_____ yes, no.

If YES depth of formation _____

Why _____

Drillers Remarks: self well
bad

CODED

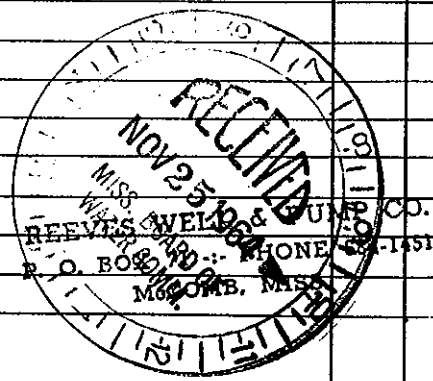

(Use Back Side)

Well No.

Mail this copy to Board of Water Commissioners 429 Miss. St. Jackson, Miss.