

FRANKLIN MISSISSIPPI BOARD OF WATER COMMISSIONERS

J<sup>9</sup>

9-23-64

CODED

WATER WELL DRILLERS LOG

Date: 9-23, 1964, Driller: Chester Reese County Franklin

(Name)

(1) Owner of Land	Description & Color of Materials Sand, Clay, Red Clay, Shell, etc.	Thick- ness Feet	Depth Feet
James Priest (Name) Rt-1, Meadville (Address)	yellow clay	20	20
	Sand & gravel	20	40
(2) Location: 1/4, 1/4, Sec. 16 T. 6 R. 4 3 miles N.E. of Budd (distance) (direction) (Nearest Town)	fine sand & clay	60	100
	white sand	11	111
(3) Topography: Hilly (Hilly) (Flat) (Low)			
(4) Purpose of Well: Domestic (Domestic Irrigation Municipal, Industrial, Other)			

Information upon completion of well:


- (1) Diameter 4 inches.
- (2) Total Depth 111 feet.
- (3) Water Level 60 feet below top of ground.
- (4) Cased to bottom, Size 4'
- (5) Screen: Size 4", Length 7'
- (6) Were any formations sealed against pollution?  
yes,  no.

If YES depth of formation \_\_\_\_\_

Why \_\_\_\_\_

Driller's Remarks: old well  
Bad.

CODED

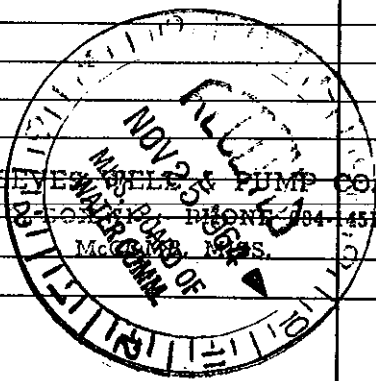

(Use Back Side)

Well No.

Mail this copy to Board of Water Commissioners 429 Miss. St. Jackson, Miss.