

J/10

9-25-64 CODED WATER WELL DRILLERS LOG

Date: 9-25, 1964, Driller: Chester Reeves County Franklin

(Name)

(1) Owner of Land	Description & Color of Materials Sand, Clay, Red Clay, Shell, etc.	Thick- ness Feet	Depth Feet
Ray Simpson Rt-1 Madulla (Name) (Address)	yellow clay	10	10
	sand & gravel	22	32
	clay	8	40
(2) Location: 1/4, 1/4 Sec 20 12 R4 1 miles East of Bude (distance) (direction) (Nearest Town)	fine sand & white chert	80	120
(3) Topography: Hilly (Hilly) (Flat) (Level)	Coarse white sand	19	139
(4) Purpose of Well: Domestic (Domestic Irrigation Municipal, Industrial, Other)			

Information upon completion of well:


- (1) Diameter 4 inches.
- (2) Total Depth 139 feet.
- (3) Water Level 30 feet below top of ground.
- (4) Cased to bottom Size 4"
- (5) Screen: Size 4', Length 7'
- (6) Were any formations sealed against pollution?
yes, no.

If YES depth of formation _____

Why _____

Drillers Remarks: red well
insufficient

CODED

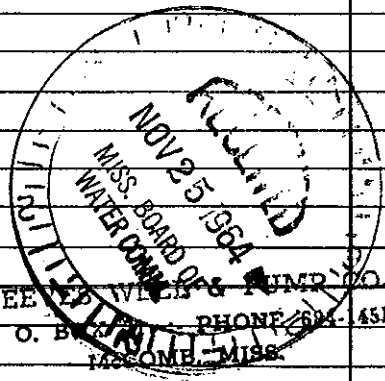

Well No.

(Use Back Side)