

FRANKLIN MISSISSIPPI BOARD OF WATER COMMISSIONERS

J 11

11-17-64

CODED

WATER WELL DRILLERS LOG

Date: 11-17, 1964, Driller: Chester Reeves County Franklin

(Name)

(1) Owner of Land:	Description & Color of Materials Sand, Clay, Red Clay, Shell, etc.	Thick- ness Feet	Depth Feet
R.R. Davis Eddiceton Miss. (Name) (Address)	Clay	12	12
(2) Location: 1/4, 1/4, Sec. 2 T. 64 N.	Sand & gravel	6	18
In Eddiceton (distance) (direction) (Nearest Town)	Blue chalk	22	40
(3) Topography: Flat (Hilly) (Flat) (Level)	fine sand	15	55
(4) Purpose of Well: Domestic (Domestic Irrigation Municipal, Industrial, Other)	Coarse sand & pea gravel	14	69

Information upon completion of well:


- (1) Diameter 4 inches.
- (2) Total Depth 69 feet.
- (3) Water Level 14 feet below top of ground.
- (4) Cased to Bottom, Size 4"
- (5) Screen: Size 4", Length 7'
- (6) Were any formations sealed against pollution?
 yes; no.

If YES depth of formation _____

Why _____

Drillers Remarks: well good

went bad.

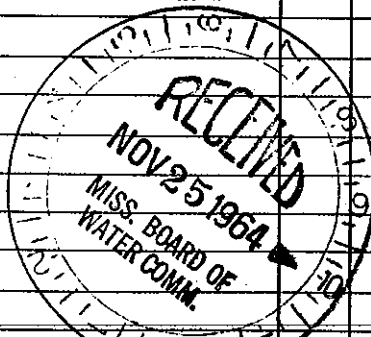

REEVES WELL & PUMP CO.
P. O. BOX 71 - PHONE 684-1851
McCOMB, MISS.

Well No.

(Use Back Side)

Mail this copy to Board of Water Commissioners 429 Miss. St. Jackson, Miss.