

FRANKLIN MISSISSIPPI BOARD OF WATER COMMISSIONERS

J 12

CODED

11-25-64

WATER WELL DRILLERS LOG

Date: 11-25, 1964, Driller: Chester Reeves County Franklin

(Name)

(1) Owner of Land:	Description & Color of Materials Sand, Clay, Red Clay, Shell, etc.	Thick- ness Feet	Depth Feet
Clark Luffing Eddington (Name) (Address)	Clay	12	12
(2) Location: 1/4, 1/4, Sec. 2 T6R4	Sand & gravel	6	18
In Eddington (distance) miles (direction) (Nearest Town)	Blue clay	64	82
(3) Topography: Flat (Hilly) (Flat) (Level)	fine white sand	32	114
(4) Purpose of Well: Domestic (Domestic Irrigation Municipal, Industrial, Other)			


Information upon completion of well:

- (1) Diameter 4 inches.
- (2) Total Depth 114 feet.
- (3) Water Level 18 feet below top of ground.
- (4) Cased to bottom size 4
- (5) Screen: Size 4, Length 7'
- (6) Were any formations sealed against pollution?
yes, no.

If YES depth of formation

Why

Drillers Remarks: well not adequate

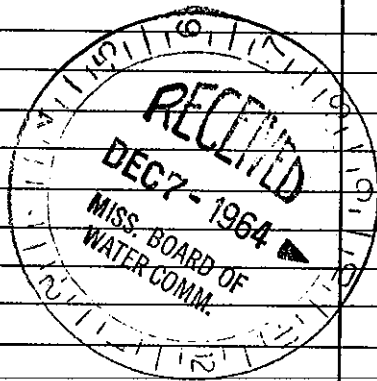

REEVES WELL & PUMP CO.
P. O. BOX 71 - PHONE 684-1451
McCOMB, MISS.

(Use Back Side)

Well No.

Mail this copy to Board of Water Commissioners 429 Miss. St. Jackson, Miss.