

FRANKLIN MISSISSIPPI BOARD OF WATER COMMISSIONERS

J 13

5-13-65 ^{CODED} WATER WELL DRILLERS LOG

Date 5-13, 1965, Driller Chester Renee County Franklin
(Name)

(1) Owner of Land:	Description & Color of Materials Sand, Clay, Red Clay, Shell, etc.	Thick- ness Feet	Depth Feet
Malkoberts A-1, Meadville (Name) (Address)	yellow clay	15	15
(2) Location: 1/4, 1/4, Sec 16 T6 R4 3 miles East of Budp (distance) (direction) (nearest Town)	Coarse sand & small gravel	40	55
(3) Topography: Flat (Hilly) (Flat) (Level)	pink chalk	15	70
(4) Purpose of Well: Domestic (Domestic Irrigation Municipal, Industrial, Other)	fine white sand	30	100
	Coarse sand & fine gravel	6	106

Information upon completion of well:


- (1) Diameter 4 inches.
- (2) Total Depth 106 feet.
- (3) Water Level 110 feet below top of ground.
- (4) Cased to bottom size 4"
- (5) Screen: Size 4", Length 7'
- (6) Were any formations sealed against pollution?
yes, no.

If YES depth of formation _____

Why _____

Drillers Remarks: red 2" well bugged sand.

CODED

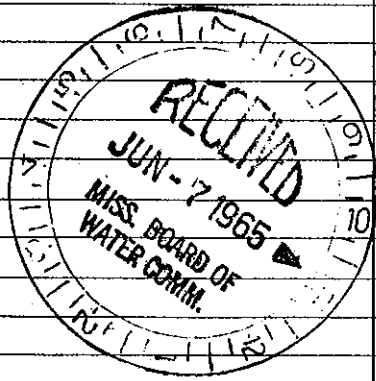

REEVES WELL & PUMP CO.
P. O. BOX 71 - PHONE 684-1451
McCOMB, MISS.

Well No.

(Use Back Side)

Mail this copy to Board of Water Commissioners 429 Miss. St. Jackson, Miss