

CODED

Franklin  
T 14  
12-66

MISSISSIPPI  
BOARD OF WATER COMMISSIONERS  
416 North State Street  
Jackson, Mississippi 39201

WATER WELL DRILLERS LOG

12-3 1966 Edgwood Water Well Co Franklin  
date well completed film name county well located

LANDOWNER: E.C. Jones  
Meadville Rt 3

(mailing address)

WELL LOCATION:  
sec 36 T 6 N R 4 E  
7 miles S-SF of Meadville  
(distance) (direction) (nearest town)

WELL PURPOSE: Home  
(home, irrigation, municipal, industrial)

WELL COMPLETION DATA:


- (1) diameter (inches) 2 1/4
- (2) total depth (feet) 179
- (3) static water level (feet) 152 below above top of ground.
- (4) casing 2 175  
(material) (depth)  
       If telescope see back.  
(size)
- (5) screen 4'  
(length) (depth to top)  
1/4 Stainless  
(size) (material)
- (6) pump 1/2 3  
(HP) (yield gpm)  
Elec  
(type power)
- (7) electric log no  
(yes or no)  
       (organization running log)
- (8) how well bottom plugged Wood Peg

description of formations encountered

from to

|                          |            |            |
|--------------------------|------------|------------|
| <u>top sand Red clay</u> | <u>0</u>   | <u>30</u>  |
| <u>Red loamy sand</u>    | <u>40</u>  | <u>60</u>  |
| <u>sand gravel</u>       | <u>35</u>  | <u>95</u>  |
| <u>White chalk</u>       | <u>30</u>  | <u>125</u> |
| <u>sand gravel</u>       | <u>55</u>  | <u>180</u> |
| <u>White chalk</u>       | <u>180</u> | <u>—</u>   |

CODED

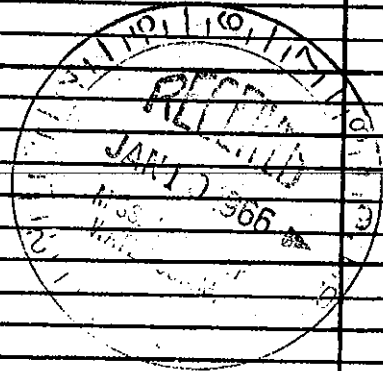

DRILLERS REMARKS: