

CODED

MISSISSIPPI BOARD OF WATER COMMISSIONERS  
416 North State Street  
Jackson, Mississippi 39201

WATER WELL DRILLERS LOG

Franklin  
575  
3-67

3-10 1967 H. Fitzgerald Water Well Service Franklin  
date well completed firm name county well located

LANDOWNER: C.F. Roland  
Route 1, Milledville  
(mailing address)

description of formations encountered	from	to
Top soil	0	10
Red sand	10	28
hard ground	28	35
White shale	35	47
Sand	47	65
Coarse sand & gravel	65	86


WELL LOCATION:  
sec. 20 T. 6 N R. 4 E  
S W  
1 miles E of Bude  
(distance) (direction) (nearest town)

WELL PURPOSE:  
(home, irrigation, municipal, industrial)

WELL COMPLETION DATA:

- (1) diameter (inches) 4
- (2) total depth (feet) 86
- (3) static water level (feet) 30 below above top of ground.
- (4) casing plastic, 78  
(material) (depth)  
4 if telescope see back.  
(size)
- (5) screen 8', 78  
(length) (depth to top)  
4, plastic  
(size) (material)
- (6) pump 1/2 hp jet - 8  
(HP) (yield gpm)  
epu  
(type power)
- (7) electric log No  
(yes or no)  
(organization running log)
- (8) how well bottom plugged Hard peg

CODED

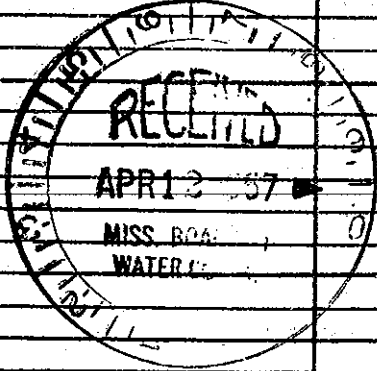

DRILLERS REMARKS: