

CODEL

MISSISSIPPI BOARD OF WATER COMMISSIONERS
416 North State Street
Jackson, Mississippi 39201

WATER WELL DRILLERS LOG

Franklin
J18
10-67

Oct 27 1967 date well completed
Reeves Well Drilling Co firm name
Franklin county well located

LANDOWNER: Leon Walker
RT-3
Meauville, Miss
(mailing address)

description of formations encountered	from	to
chalk & gravel	0	20
red sand & gravel	20	55
caprock & white	55	105
fine sand	105	125
coarse sand & gravel	125	151

WELL LOCATION:
sec. 36 T-6 N R-4 E
6 miles E-SE of Bull -
(distance) (direction) (nearest town)

WELL PURPOSE: Home
(home, irrigation, municipal, industrial)


WELL COMPLETION DATA:
(1) diameter (inches) 4"
(2) total depth (feet) 151
(3) static water level (feet) 144 below top of ground.
(4) casing Plastic Bottom
(material) (depth)

(5) screen 6' length 145' depth to top
4" (size) plastic (material)
(6) pump 3/4 sub (HP) 10 (yield gpm)
elect. (type power)

(7) electric log NO (yes or no)
(organization running log)

(8) how well bottom plugged
wooden plug

DRILLERS REMARKS:
old well had

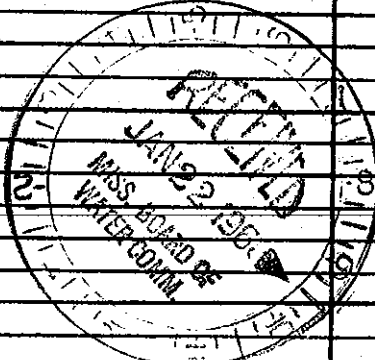

CODEL