

State Well Report

Part 1

Mississippi Department of Environmental Quality
Office of Land and Water Resources
P.O. Box 10631
Jackson, MS 39289-0631
(601)961-5210
(601)354-6938 (fax)

For Office Use Only:

Aquifer: J62
Well #:
L. S. Elevation:
E-log #:

County: Franklin
Permit #:
Driller: Gary Rayborn
Date drilling completed: 8/21/10

State Law requires that this report be prepared by the driller in detail and filed with the Department within 30 days of completion of drilling of the well.

Well Owner Information: Energy Drilling, PO Box 905, Natchez MS 39121, (601) 446-5259
Well Location: Latitude 31.30.24, Longitude 90.45.19.44, Method of Lat/Long: Conventional Survey, Google Earth, USGS quad, Hand-held GPS, Survey-grade GPS, NE 1/4 NE 1/4 Sec 6, Twn 6N, Rng 5E, Distance 0 Miles, Direction of Quentin

Well Data: Purpose of Well (Other: Riq Supply), Date well drilling started/completed: 8/21/10, Static Water Level: 75 feet above or below land surface, Method of Measurement: electric tape, Hole depth: 220', Well depth: 220', Well grouted to a depth of 10 feet, Type of grout: Cement, Casing length: 200 feet, Casing diameter: 4 inches, Type of casing: PVC, Screen length: 20 feet, Screen diameter: 4 inches, Type of screen: PVC, Screen slot size: .020 inches, Setting depth: From 200 feet to 220 feet, Type of completion: Gravel packed

Name of organization running log(s):
I certify that the well was drilled, constructed, and completed in accordance with all applicable requirements of the Mississippi Department of Environmental Quality and/or the Mississippi Department of Health regulations and state laws.

RAYBORN DRILLING, INC. 0-60
Signature of Water Well Contractor

RECEIVED
SEP 10 2010
BY: OLWR

Faint, illegible text at the top of the page, possibly a header or introductory paragraph.

Large block of faint, illegible text in the middle section of the page.

REYBORN PRINTING INC

OPS 2 122

Faint text at the bottom left corner.

STATE WELL REPORT

Part 2

Pump Installer's Completion Report
 Mississippi Department of Environmental Quality
 Office of Land and Water Resources
 P.O. Box 10631
 Jackson, MS 39289-0631
 (601)961-5210
 (601)354-6938 (fax)

County: Franklin
 Permit #: _____
 Driller: Gary Rayborn
 Date completed: 8/21/10

For Office Use Only:

Aquifer: J62
 Well #: _____
 Elevation: _____

This report should be prepared by the pump installer in detail and filed with the Department within 30 days of the installation of pump.

Well Owner Information	Well Location
Owner Name: <u>Energy Drilling</u>	Latitude: <u>31°30'24" N</u> Longitude: <u>90°45'19.44" W</u>
Mailing Address: <u>PO Box 905</u>	Method of Lat/Long (circle one): <u>Google Earth</u> Conventional Survey, _____
<u>Natchez</u> <u>MS</u> <u>39121</u>	USGS quad, Hand-held GPS, Survey-grade GPS
City State Zip Code	_____ 1/4 _____ 1/4 Sec <u>6</u> Twn <u>6N</u> Rng <u>5E</u>
Telephone No. <u>(601) 446-5259</u>	Distance Direction Nearest Town
	<u>0</u> Miles <u>at</u> of <u>Quantico</u>

Pump Type Circle one	Power Type Circle one
Air Lift Jet <input type="radio"/> <input checked="" type="radio"/> <u>Submersible</u>	Diesel Engine Gasoline Engine Natural Gas
Bucket Piston <input type="radio"/> <input type="radio"/> <u>Turbine</u>	<input checked="" type="radio"/> <u>Electric Motor</u> Hand Tractor PTO
Centrifugal Rotary <input type="radio"/> <input type="radio"/> <u>Flowing Well</u>	Windmill Other (specify): _____
Other (specify): _____	Horse Power Rating of Motor: <u>5 HP</u>
Date Pump Installed: <u>8/21/10</u>	Setting Depth: <u>147</u> feet
Rated Pump Capacity: <u>60</u> Gallons Per Minute	Number of Stages: <u>11</u>

Pump Test Data	Method of Measuring Water Level Circle one
Date Well Tested: <u>8/21/10</u>	Air Line <input type="radio"/> <input checked="" type="radio"/> <u>Electric Measuring Line</u> Steel Tape
Static Water Level (A): <u>75</u> Feet Below Land Surface	Other (specify): _____
Pumping Water Level (B): _____ Feet Below Land Surface	For flowing well, measured shut in head: _____ feet
Drawdown [(B) - (A)]: _____ Feet Below Land Surface	Well yielded <u>70</u> GPM with a drawdown of _____ feet after _____ hours of pumping
Test Pumping Rate: <u>70</u> Gallons Per Minute	
Duration of Pump Test (minimum 4 hours): _____ hours	

I HEREBY CERTIFY that the above statements are true to the best of my knowledge.

Gary Rayborn 0-60 _____
 Print Name of Pump Installer and License No. (if applicable) Signature of Pump Installer

RECEIVED
 SEP 10 2010
 BY: OLWR

If well telescopes please sketch below and show depths.


J62

Ground Level

Description of Formations Encountered	From	To
Chalk	0	15
Large Gravel	15	40
Chalk	40	140
Medium Sand	140	180
Coarse Sand	180	220

If more than one screen, show location of each on sketch

Sketch the property layout and include the following: 1) the well location; 2) any permanent structures on the property that may aid in locating the well; 3) any roads, power lines, or other items that may aid in locating the property and the well; 4) indicate direction.

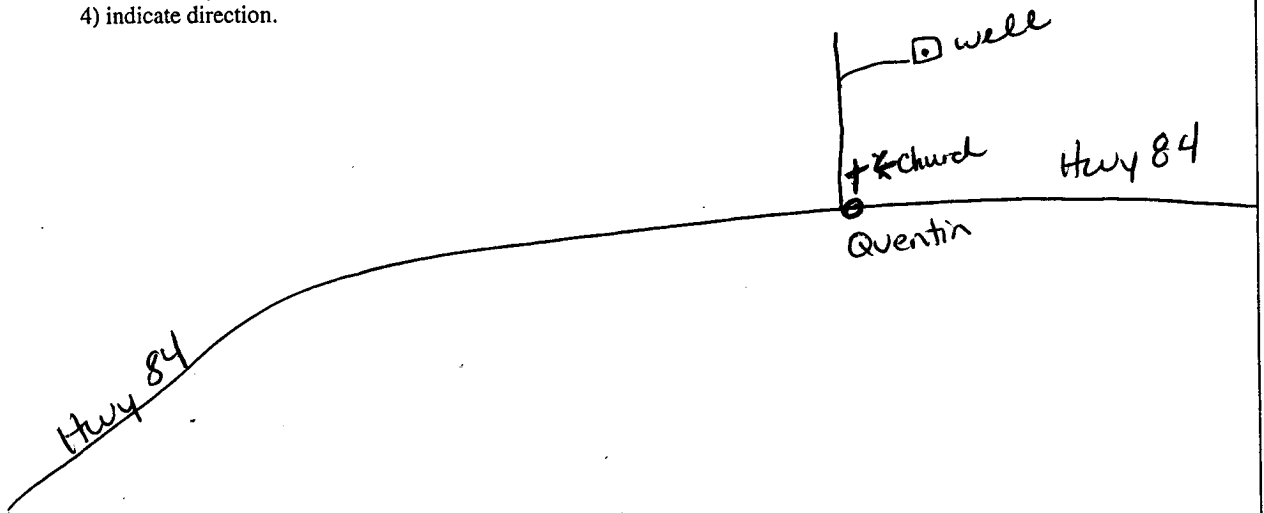

Landowner Name: _____

[Handwritten Signature]

Signature of Water Well Contractor

RECEIVED
SEP 10 2010
BY: OLWR