

MISSISSIPPI DEPARTMENT OF ENVIRONMENTAL QUALITY

Office of Land and Water Resources

P. O. Box 10631
Jackson, MS 39289-0631
WATER WELL DRILLERS LOG

COUNTY WELL LOCATED Franklin	
WELL NUMBER J 2029	CODED
DATE WELL COMPLETED 7-12-95	

PERMIT NUMBER
NAME OF DRILLING FIRM Green Water Well Supply

NAME & MAILING ADDRESS OF LANDOWNER Rhetta Bravis			
Ht. 1, Box 73-1			
Meadville, MS			
WELL LOCATION	SEC	TOWNSHIP	RANGE
	24	6 N	4 E
DISTANCE	DIRECTION	NEAREST TOWN	
2 1/2 Miles	SE	of Eddiceton	
OTHER LANDMARK			
WELL PURPOSE <input checked="" type="checkbox"/> Home, <input type="checkbox"/> Irrigation, <input type="checkbox"/> Municipal, <input type="checkbox"/> Industrial, <input type="checkbox"/> Fish Pond, etc.			

PUMP DATA		
PUMP TYPE (Circle One): <input checked="" type="checkbox"/> Submersible, <input type="checkbox"/> Turbine, <input type="checkbox"/> Jet, <input type="checkbox"/> Flowing Well, Other (Describe) _____		
POWER TYPE (Circle One): <input checked="" type="checkbox"/> Electric, <input type="checkbox"/> Tractor, <input type="checkbox"/> Diesel, <input type="checkbox"/> Gasoline, <input type="checkbox"/> Butane, Other (Describe) _____ H/P 1/2		
Pump Capacity (GPM)	No. of Stages	Setting Depth
10	9	50 FT.
PUMP TEST		
Well yielded 10 GPM with		
a drawdown of 0 ft.		
after 1 hours of pumping		

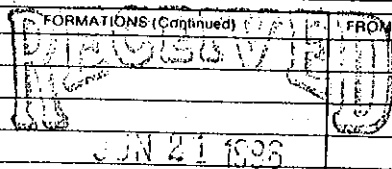
WELL DATA		
Well Depth 180	Casing Diameter (In.) 4	Casing Length (Ft.) 170
Type of Casing PVC	Hole Depth 180	Depth to Static Water Level 18
TYPE OF COMPLETION: (Circle One or More): <input checked="" type="checkbox"/> Gravel Packed, <input type="checkbox"/> Underreamed, <input type="checkbox"/> Telescoped, <input type="checkbox"/> Natural Development, <input type="checkbox"/> Open Hole, <input type="checkbox"/> Other (Describe) _____		
WELL GROUTED TO A DEPTH OF 10 FEET Type Grout (circle one): Cement, Bentonite, or <input checked="" type="checkbox"/> Mix		

LOG DATA	
TYPE OF LOG RUN (Circle One): <input checked="" type="checkbox"/> No Log Run, Electric, Gamma Ray, Density, Sonic, Neutron, Other (Describe) _____	
Name of Organization Running Log	

GEOLOGIC DATA (Office Use Only)			
Surface Elev.	Geologic Unit	Unit Thickness	Depth to Top
Subs. SWL	Date	Analysis	Aquifer Test

Driller's Remarks			
Top of Lap Pipe or Reduction in Casing			
FEET		IF TELESCOPED OR MORE THAN ONE SCREEN: USE BACK PAGE	

SCREEN DATA		
Diameter - Inches 4	Length - Feet 10	Slot Size - Inches .010
Screen Type PVC	Depth to Bottom - Feet 170	

DESCRIPTION OF FORMATIONS ENCOUNTERED	FROM	TO	FORMATIONS (Continued)	FROM	TO
Red Clay	0	7			
Gravel	7	14			
White Clay	14	32			
Blue Clay	32	126			
Sand	126	180			
Dept. of Environmental Quality Office of Land & Water Resources					
IF MORE SPACE IS NEEDED, USE BACK					