

FRANKLIN MISSISSIPPI BOARD OF WATER COMMISSIONERS

K5

7-17-60

CODED

WATER WELL DRILLERS LOG

K 202
CODED

Date: July 17, 1960, Driller: Heppner Sevensall Inc. County Franklin
(Name)

	Description & Color of Materials Sand, Clay, Red Clay, Shell, etc.	Thick- ness Feet	Depth Feet
(1) Owner of Land: <u>Hattie Backles</u> (Name)	<u>25' Red Clay</u>	<u>25'</u>	<u>0</u>
<u>McCall Creek, Miss.</u> (Address)	<u>Sand & gravel</u>	<u>45'</u>	<u>25</u>
(2) Location: <u>1/4</u> , <u>1/4</u> , Sec. <u>4</u> T <u>6</u> R <u>5</u>	<u>Shell</u>	<u>50'</u>	<u>70</u>
<u>1/2</u> miles <u>S.W.</u> of <u>McCall</u> (distance) (direction) (Nearest Town)	<u>SAND</u>	<u>40'</u>	<u>120</u>
(3) Topography: _____ (Hilly) (Flat) (Level)			
(4) Purpose of Well: <u>Domestic</u> (Domestic Irrigation Municipal, Industrial, Other)			

CODED

Information upon completion of well:

(1) Diameter 4 3/4 inches.

(2) Total Depth 170' feet.

(3) Water Level 103 feet below top of ground.

(4) Cased to 165', Size 2"


(5) Screen: Size 2", Length 5'

(6) Were any formations sealed against pollution?
 _____ yes, no.

If YES depth of formation _____

Why _____

Drillers Remarks: _____

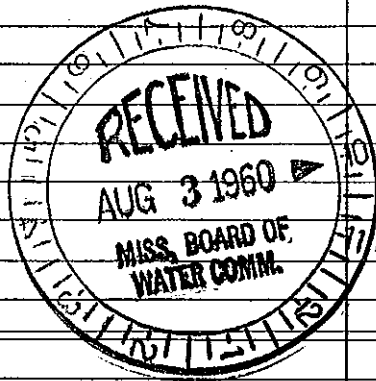

Well No.

(Use Back Side)

Mail this copy to Board of Water Commissioners 429 Miss. St. Jackson, Miss.