

FRANKLIN MISSISSIPPI BOARD OF WATER COMMISSIONERS

K6

CODED

WATER WELL DRILLERS LOG

12-21-61

Date: 12-21, 1961, Driller: W.L. Massey County Franklin

(Name)

(1) Owner of Land:	Description & Color of Materials Sand, Clay, Red Clay, Shell, etc.	Thick- ness Feet	Depth Feet
Mrs. Adelaide M. Becker (Name)	Topsail & Clay	0	15
Queenston, Miss. (Address)	Sand & gravel	15	25
(2) Location: 1/4, 1/4, Sec. 7 T. R. 10	White Chalk	25	140
IN the town of Queenston	Fine Sand growing bare	40	150
(distance) (direction) (Nearest Town)	Coarse Sand	150	165
(3) Topography: (Hilly) (Flat) (Level)			
(4) Purpose of Well: Commercial (Domestic Irrigation Municipal, Industrial, Other)			

Information upon completion of well:

(1) Diameter 4 inches.

(2) Total Depth 169 feet.

(3) Water Level \_\_\_\_\_ feet below top of ground.

(4) Cased to 161, Size 4"


(5) Screen: Size 2", Length 8'

(6) Were any formations sealed against pollution?  
\_\_\_\_\_ yes,  no.

If YES depth of formation \_\_\_\_\_

Why \_\_\_\_\_

Drillers Remarks: \_\_\_\_\_

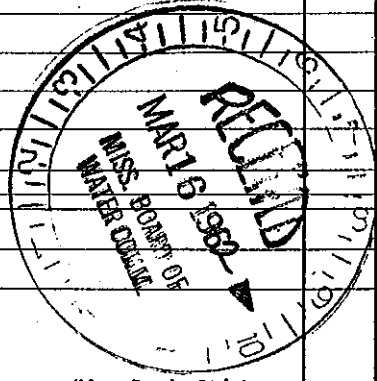

Well No.

(Use Back Side)

Mail this copy to Board of Water Commissioners 429 Miss. St. Jackson, Miss.