

FRANKLIN

MISSISSIPPI BOARD OF WATER COMMISSIONERS

K7

CODED

WATER WELL DRILLERS LOG

CODED

6-3-65

Date: 6-3, 1965, Driller: Chester Keen County Franklin

(Name)

(1) Owner of Land:	Description & Color of Materials Sand, Clay, Red Clay, Shell, etc.	Thick- ness Feet	Depth Feet
Lucien Baptist Church Lucien (Address)	Top soil Sand	5 10	5 15
(2) Location: 1/4, 1/4, Sec. 1 T6 R5	white chalk	27	42
in Lucien (distance) (direction) (Nearest Town)	fine sand	124	166
(3) Topography: Flat (Hilly) (Flat) (Level)	coarse sand	40	206
(4) Purpose of Well: Domestic (Domestic Irrigation Municipal, Industrial, Other)			

Information upon completion of well:

- (1) Diameter: 2 inches.
- (2) Total Depth: 206 feet.
- (3) Water Level: artesian - feet below top of ground.
- (4) Cased to: Bottom 2"
- (5) Screen: Size 1/4, Length 10'
- (6) Were any formations sealed against pollution?
yes, no.


REEVES WELL & PUMP CO.
P. O. BOX 71 -- PHONE 684-1451
McCOMB, MISS.

If YES depth of formation

Why

Drillers Remarks: red well bad

CODED

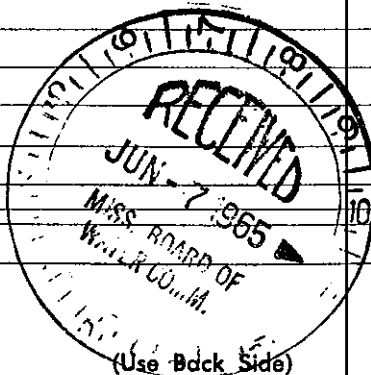

Well No.

Mail this copy to Board of Water Commissioners 429 Miss. St. Jackson, Miss