

Franklin
K8
8-66

CODED

MISSISSIPPI BOARD OF WATER COMMISSIONERS

WATER WELL DRILLERS LOG

Date: Aug 5 1966, Driller: Keenan Well Drilling County: Franklin
(When well drilled) (Name) (Where well is located)


(1) Owner of Land	Description & Color of Materials Sand, Clay, Red Clay, Shell, etc.	Thick- ness Feet	Depth Feet
<u>James Sumner</u> <small>(Name)</small> <u>RFD, McCall Creek</u> <small>(Address)</small>	<u>yellow clay</u>	<u>25</u>	<u>25</u>
(2) Location: <u>1/4</u> , <u>1/4</u> , Sec. <u>33 T6 R5</u>	<u>orange yellow</u> <u>sand mixed with</u> <u>chalk</u>	<u>55</u>	<u>80</u>
<u>6</u> miles <u>S.E.</u> of <u>McCall</u> <small>(distance) (direction) (Nearest town)</small>	<u>Coarse sand of</u> <u>sea gravel</u>	<u>20</u>	<u>100</u>
(3) Topography: <u>Hilly</u> <small>(Hilly) (Flat) (Level)</small>			
(4) Purpose of Well: <u>Domestic</u> <small>(Domestic Irrigation Municipal, Industrial, Other)</small>			

Information upon completion of well:

- (1) Diameter 4" inches.
- (2) Total Depth 100 feet.
- (3) Water Level 77 feet below top of ground.
- (4) Cased to Bottom Size 4'
- (5) Screen: Size 1/2", Length 6'
- (6) Were any formations sealed against pollution?
 yes, no.

CODED

If YES depth of formation _____
 Why _____
 Drillers Remarks: _____
 Yield in gpm: 15
 Size pump: 1/2 H.P. Sub-
 Type power: Electric

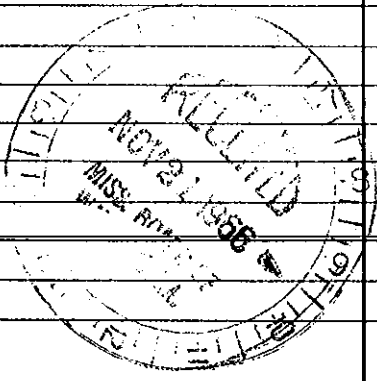

Mail this copy to Board of Water Commissioners 429 Miss. St. Jackson, Miss.