

CODED

MISSISSIPPI
BOARD OF WATER COMMISSIONERS
416 North State Street
Jackson, Mississippi 39201

Franklin
K10
3-67

WATER WELL DRILLERS LOG

Franklin
~~Lincoln~~

March 3 1967 GEEVES WELL & PUMPS Franklin
date well completed firm name county well located

LANDOWNER: George Hunter
P.O. Box 211
Brookhaven
(mailing address)


description of formations encountered	from	to
Red sand clay	0	16
brown sand & gravel	16	35
yellowish sand	35	65
Coarse sand & gravel	65	71

WELL LOCATION:
sec. 7 T. 6 N. R. 6 E.
2 miles SE of Lucien
(distance) (direction) (nearest town)

WELL PURPOSE: Home
(home, irrigation, municipal, industrial)

- WELL COMPLETION DATA:
- (1) diameter (inches) 2"
 - (2) total depth (feet) 71
 - (3) static water level (feet) 60 below top of ground.
 - (4) casing 2" galv. bottom-
(material) (depth)
2" If telescope see back
(size)
 - (5) screen 6' 65"
(length) (depth to top)
1/4" plastic
(size) (material)
 - (6) pump 2 HP 2
(type power) (yield gpm)
 - (7) electric log NO
(yes or no)
(organization running log)
 - (8) how well bottom plugged

CODED

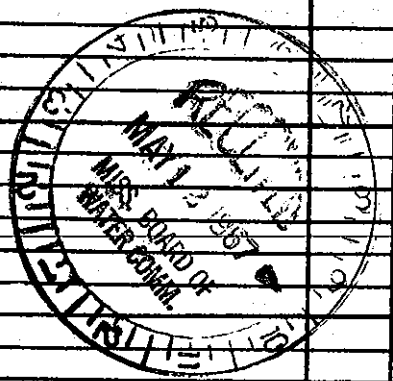

DRILLERS REMARKS: