

CODED

MISSISSIPPI
BOARD OF WATER COMMISSIONERS
416 North State Street
Jackson, Mississippi 39201

WATER WELL DRILLERS LOG

Franklin
K12
9-64

9-22-1964 date well completed
67th Street Water Well firm name
Franklin county well located

LANDOWNER: <u>Mrs. G. White</u> <u>Mrs. G. White</u> (mailing address)	description of formations encountered	from	to
	Top Soil	0	4
	Gravel	4	20
	White Chalk	20	35
	Sand	35	150
	Sand & gravel	150	161


WELL LOCATION:
sec. 4 T 6 N R. 5 E
S W
1 miles (distance) W (direction) of Mrs. G. White (nearest town)

WELL PURPOSE:
(home, irrigation, municipal, industrial)

WELL COMPLETION DATA:

- (1) diameter (inches) 4
- (2) total depth (feet) 161
- (3) static water level (feet) 20 below top of ground.
- (4) casing plastic (material) 155 (depth)
4 1/2 (size) If telescope see back.
- (5) screen 6 (length) 155 (depth to top)
4 1/2 (size) plastic (material)
- (6) pump 2 1/2 (HP) (yield gpm)
- (7) electric log yes (yes or no)
- (8) how well bottom plugged wood plug

DRILLERS REMARKS:

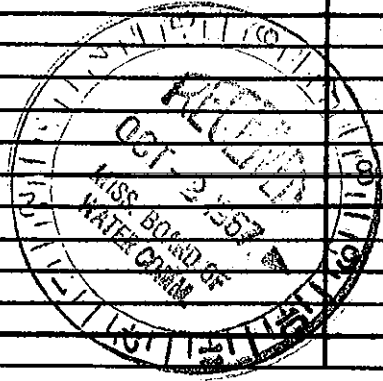

CODED