

MISSISSIPPI BOARD OF WATER COMMISSIONERS

K13  
10-12-62

WATER WELL DRILLERS LOG

**CODED**

Date: 10-12, 1962, Driller: Werring Pump Co County Franklin  
(Name)

(1) Owner of Land:	Description & Color of Materials Sand, Clay, Red Clay, Shell, etc.	Thick- ness Feet	Depth Feet
<u>JJ Wallace</u> (Name)	<u>Clay</u>	<u>50</u>	<u>50</u>
<u>Mc Creep Miss</u> (Address)	<u>Sand</u>	<u>60</u>	<u>60</u>
(2) Location: $\frac{1}{4}$ , $\frac{1}{4}$ , Sec. <u>4</u> to <u>N</u> <u>SE</u>			
_____ miles _____ of <u>Mc Creep</u> (distance) (direction) (Nearest Town)			
(3) Topography: <u>domestic</u> (Hilly) (Flat) (Level)			
(4) Purpose of Well: <u>domestic</u> (Domestic Irrigation Municipal, Industrial, Other)			

**CODED**


Information upon completion of well:

- (1) Diameter 4 3/4 inches.
- (2) Total Depth 110 feet.
- (3) Water Level 25 feet below top of ground.
- (4) Cased to 105, Size 2"
- (5) Screen: Size R, Length 5
- (6) Were any formations sealed against pollution?  
 yes,  no.

If YES depth of formation \_\_\_\_\_

Why \_\_\_\_\_

Drillers Remarks: \_\_\_\_\_

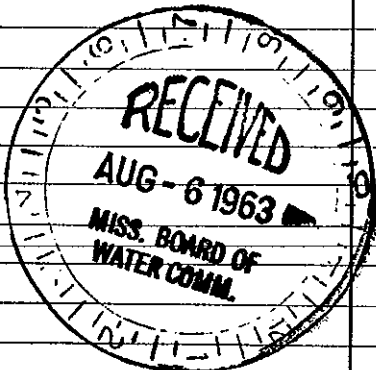

Well No. \_\_\_\_\_

(Use Back Side)

Mail this copy to Board of Water Commissioners 429 Miss. St. Jackson, Miss