

Franklin  
K15  
10-16-68

MISSISSIPPI  
BOARD OF WATER COMMISSIONERS  
416 North State Street  
Jackson, Mississippi 39201

CODED

WATER WELL DRILLERS LOG

10-16 1968 *Fitzgerald Well Drilling* Franklin  
date well completed firm name county well located

LANDOWNER:  
*Hardy Dennis*  
*R.R. B... Little*  
(mailing address)

WELL LOCATION:  
sec. 22 T 6 N R 5 E  
S W  
20 miles E of Brookhaven  
(distance) (direction) (nearest town)

description of formations encountered	from	to
<i>Red clay</i>	<i>0</i>	<i>20</i>
<i>Red sand</i>	<i>20</i>	<i>80</i>
<i>Red gravel</i>	<i>80</i>	<i>90</i>
<i>White clay</i>	<i>90</i>	<i>130</i>
<i>Coarse sand</i>	<i>130</i>	<i>160</i>

WELL PURPOSE:  
(home, irrigation, municipal, industrial)

WELL COMPLETION DATA:

(1) diameter (inches) 4

(2) total depth (feet) 160

(3) static water level (feet) 80 below above top of ground.


(4) casing Plastic, 154,  
(material) (depth)  
4 if telescope see back.  
(size)

(5) screen 6, 154  
(length) (depth to top)  
4, Plastic  
(size) (material)

(6) pump 3, 3  
(HP) (yield gpm)  
Electric  
(type power)

(7) electric log Yes  
(yes or no)  
(organization running log)

(8) how well bottom plugged seal plug

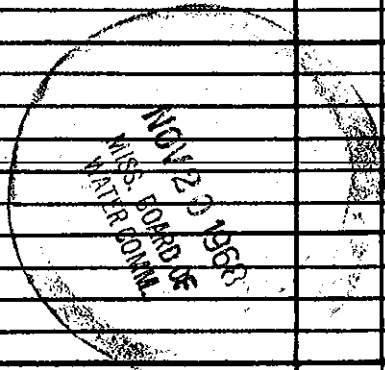

DRILLERS REMARKS: