

FRANKLIN  
K 22

MISSISSIPPI BOARD OF WATER COMMISSIONERS

WATER WELL DRILLERS LOG

**CODED**

9-4-63


Date: 9/4/63, 1963, Driller: Roy Chandler Jr County Franklin  
(Name)

(1) Owner of Land:		Description & Color of Materials	Thick-ness Feet	Depth Feet
<u>(S.O.) Orvis Parter Jr</u> (Name) <u>owns store at McCall</u> (Address)		<u>yellow clay -</u>	<u>10</u>	<u>10</u>
<u>Creek</u>		<u>Gravel</u>	<u>8</u>	<u>8</u>
<u>pipe</u>		<u>white sand</u>	<u>8</u>	<u>8</u>
(2) Location: <u>1/4</u> , <u>1/4</u> , Sec. <u>4</u> <u>W 5E</u>		<u>Blue, green, gray</u>		
<u>4</u> <u>W 5E</u>		<u>Red pipe clay</u>	<u>34</u>	<u>34</u>
_____ miles _____ of _____ (distance) (direction) (Nearest Town)				
(3) Topography: _____ (Hilly) (Flat) (Level)				
(4) Purpose of Well: <u>house</u> (Domestic Irrigation Municipal, Industrial, Other)				

**CODED**

Information upon completion of well:

- (1) Diameter 15" inches.
  - (2) Total Depth 36' feet.
  - (3) Water level 18' feet below top of ground.
  - (4) Cased to 60', Size 15"
  - (5) Screen: Size None Length \_\_\_\_\_
  - (6) Were any formations sealed against pollution?  
Cemented down 4 feet  
 yes, \_\_\_\_\_ no.
- If YES depth of formation 4'
- Why Keep out surface water

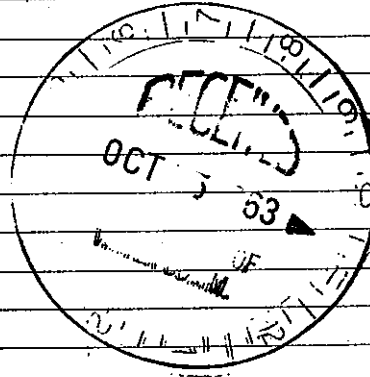

Drillers Remarks:

(Use Back Side)

Well No.