

FRANKLIN
K 23

MISSISSIPPI BOARD OF WATER COMMISSIONERS

CODED

WATER WELL DRILLERS LOG

10-7-63

Date: 10/7/1963, Driller: Roy Chandler Jr. Franklin
Burris (Name)


		Description & Color of Materials Sand, Clay, Red Clay, Shell, etc.	Thick- ness Feet	Depth Feet
(1) Owner of Land: Leon Burris (Name) ask at McCall Creek (Address) Post office		yellow clay	3	3
(2) Location: 1/4, 1/4, Sec 22 T. 8 R. 5E		Dravel water sand	17	17
		Dray pipe clay	4	4
			11	11

_____ miles _____ of _____
(distance) (direction) (Nearest Town)

(3) Topography: _____
(Hilly) (Flat) (Level)

(4) Purpose of Well: house
(Domestic Irrigation
Municipal, Industrial, Other)

CODED

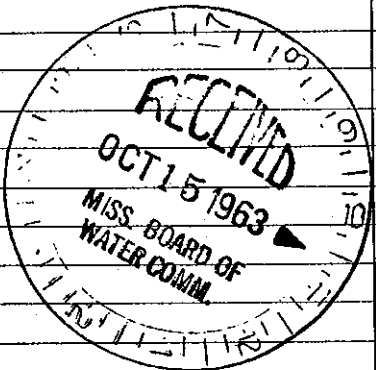

Information upon completion of well:

- (1) Diameter 15" inches.
- (2) Total Depth 35 feet.
- (3) Water level 22 feet below top of ground.
- (4) Cased to 35, Size 15"
- (5) Screen: Size none, Length _____
- (6) Were any formations sealed against pollution?
Dravel packed 6' up
yes, no.
dirt packed back around
If YES depth of formation civil then
Why Cemented down 3'
- Drillers Remarks: Keep out surface
water

Well No.

(Use Back Side)