

FRANKLIN

K24 MISSISSIPPI BOARD OF WATER COMMISSIONERS

7-26-66

WATER WELL DRILLERS LOG

CODED

Franklin

Date: July 26, 1966, Driller: W.L. Massey County: Franklin

(When well drilled) (Name) (Where well is located)

1) Owner of Land: James Ealey
(Name)
Lucian
(Address)

2) Location: 1/4, 1/4, Sec. 1 T. 6^N 5^E R.
0 miles Lucian, of Lucian
(distance) (direction) (Nearest Town)

3) Topography: (Hilly) (Flat) (Level)

4) Purpose of Well: (Domestic Irrigation) (Municipal, Industrial, Other)

Description & Color of Materials Sand, Clay, Red Clay, Shell, etc.	Thick- ness Feet	Depth Feet
Top Soil	0	15
Sand	15	30
White Chalk	35	75
Blue Chalk	75	105
Grey Sand	115	160
White Chalk	160	260

CODED

Information upon completion of well:

1) Diameter 4 inches.

2) Total Depth 155 feet.

3) Water Level 20 feet below top of ground.

4) Cased to 147, Size 4

5) Screen: Size 4, Length 8

6) Were any formations sealed against pollution?
no

YES depth of formation _____


Why _____

Drillers Remarks: _____

Yield in gpm: _____

Size pump: 1/2 HP Jet

Type power: Elec

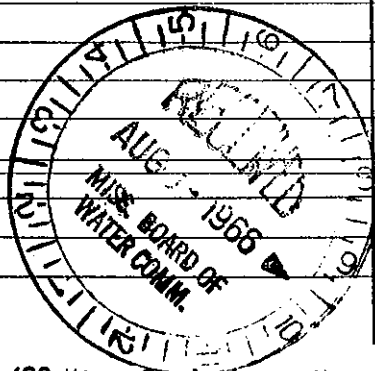

Mail this copy to Board of Water Commissioners 429 Miss. St. Jackson, Miss.