

FRANKLIN
K 37
2-20-74

MISSISSIPPI
 BOARD OF WATER COMMISSIONERS
 416 North State Street
 Jackson, Mississippi 39201

CODED

WATER WELL DRILLERS LOG

Feb 20 1974 Chester Keener Franklin
 date well completed firm name county well located

LANDOWNER: George Hunter
St. S. Brookhaven

description of formations encountered	from	to
clay	0	14
clay & gravel	14	26
red sand	26	38
red chalk	38	60
fine red sand	60	65
sand & gravel	65	72
white & blue chalk	72	118
fine sand	118	133
coarse sand	133	143

(mailing address)

WELL LOCATION:
 sec. 13 T. 6 N. R. 5 E
2 1/2 miles South of Lucien
 (distance) (direction) (nearest town)

WELL PURPOSE: Home
 (home, irrigation, municipal, industrial)


WELL COMPLETION DATA:

- (1) diameter (inches) 4"
- (2) total depth (feet) 143
- (3) static water level (feet) 111 below top of ground
- (4) casing Plast Ballou
 (material) (depth)
 (size) if telescope see back.
- (5) screen 6' 132'
 (length) (depth to top)
4" Plast
 (size) (material)
- (6) pump 1/2 12
 (HP) (yield gpm)
Elect
 (type power)
- (7) electric log NO
 (yes or no)

(organization running log)

(8) how well bottom plugged
wood plug

DRILLERS REMARKS:
all 2" well pumped sand

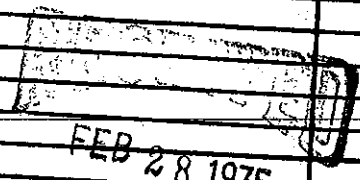

MISS. BD. OF WATER COMM