•	Il Report Marshall et al No 1 For Office Use Only:
State We	For Office Use Only:
Company FIGAAKIIA	
Permit #: Office of Land and	Water Percurees
Driller: Gary Rayburn Jackson, MS	
Date drilling completed: $92910$ (601)96 (601)354-0	
State Law requires that this report be prepared by the days of completion of drilling of the well.	riller in detail and filed with the Department within
Well Owner Information	Well Location
	Latitude: <u>31 • 30 · 14 "</u> Longitude: <u>40 • 44 · 35</u> "
Mailing Address: POBOX 905	Method of Lat/Long (circle one): Conventional Survey,
	USGS quad, Hand-held GPS, Survey-grade GPS
Notchez MS 39120 City State Zip Code	<u>5 W14 NE 14 Sec 7 Twn 6N Rng5E</u>
$\frac{\text{City}}{\text{Felephone No.}} \underbrace{401}_{\text{UP}} \underbrace{446 - 5259}_{\text{UP}}$	Distance Direction Nearest Town
Well Da	40
Ruppers of Well (circle one) Home Industrial Public Supply	Irrigation Fish Culture Other; Rig Supply
Date well drilling started: $9-29-10$ Date w	ell drilling completed:
If flowing, method of flow regulation: Valve Other (de	scribe)
Static Water Level: <u>35</u> feet above or below (circle one) la	nd surface Date measured: <u>9-29-10</u>
Mathad of Measurement (circle one) steel tape (electric tape)	air line other:
Hole depth: $130'$ Well depth: $130'$	Well grouted to a depth offeet
Type of grout (circle one): Cement Bentonite Mix	
All	inches Type of casing: PVC
Casing length:feet Casing diameter:	
Screen length: <u>20</u> feet Screen diameter: <u>4</u>	_inches Type of screen: PVC
Screen slot size: <u>1020</u> inches Setting depth: From_	110 130
Type of completion (circle all applicable): Gravel packed Under	eamed Telescoped Open hole Natural Development
Other (describe):	
Top of lap pipe or reduction in casing:feet. If te	lescoped or more than one screen, describe on back of page
Logs run (circle all applicabe): No log run Electric Gamma Ray	Density Sonic Neutron Other:
Name of organization running log(s):	
I certify that the well was drilled, constructed, and completed in a	ccordance with all applicable requirements of the Mississippi
Department of Environmental Quality and/or the Mississippi Dep	partment of Health regulations and state laws.
RAYBORN DRILLING, INC. 0-60	
Print Name of Water Well Contractor and License No.	Signature of Water Well Contractor
	BY: DIV

STATE WELL REPORT			
County: <u>Franklin</u> Permit #: <u>Gang Rayborn</u> Driller: <u>Gang Rayborn</u> Date completed: <u>9-29-10</u> Pump Installer's Mississippi Departmen Office of Land a P.O. E Jackson, M (601) (601)35	art 2   For Office Use Only:     Completion Report   Aquifer:     t of Environmental Quality   Aquifer:     Matter Resources   Well #:     Sox 10631   Well #:     961-5210   Elevation:     4-6938 (fax)   Control to the total total to the total to		
This report should be prepared by the pump installer in detai installation of pump.			
Well Owner Information Owner Name: <u>Energy Drilling</u> , <u>Inc</u> Mailing Address: <u>POBOX 905</u> <u>Natchez MS 39120</u> <u>City State Zip Code</u> Telephone No. ( <u>601)</u> , <u>44 6 - 5259</u>	Well Location     Latitude:   Longitude:     Method of Lat/Long (circle one): Conventional Survey,     USGS quad, Hand-held GPS, Survey-grade GPS    14   SecTwn_6N_Rng_5E    14   SecTwn_6N_Rng_5E     Distance   Direction     Nearest Town		
Pump Type   Circle one   Air Lift   Jet     Submersible	Power Type Circle one Diesel Engine Gasoline Engine Natural Gas		
Bucket Piston Turbine	Electric Motor Hand Tractor PTO		
Centrifugal   Rotary   Flowing Well     Other (specify):	Windmill   Other (specify):     Horse Power Rating of Motor:   5 H P     Setting Depth:   8 4 feet     Number of Stages:   11		
Pump Test Data     Date Well Tested:   9-29-10     Static Water Level (A):   35     Feet Below Land Surface     Pumping Water Level (B):   Feet Below Land Surface	Method of Measuring Water Level Circle one Air Line Electric Measuring Line Steel Tape Other (specify):		
Drawdown [(B) – (A)]:Feet Below Land Surface Test Pumping Rate:Gallons Per Minute Duration of Pump Test (minimum 4 hours):hours	For flowing well, measured shut in head:feet Well yieldedGPM with a drawdown of feet afterhours of pumping		
I HEREBY CERTIFY that the above statements are true to the best <u>Gary Rayborn</u> O-Co Print Name of Pump Installer and License No. (if applicable)	of my knowledge. Signature of Pump Installe OCT 1 3 2010		


BY: OWF

If well telescopes please sketch below and show depths.



Description of Formations Encountered	From	To
Chalk	0	10
GRAVEL	10	30
CHALK	30	65
FINE SAND	63	100
COARSE SAND	100	130
· · · · · · · · · · · · · · · · · · ·		
· · · · · · · · · · · · · · · · · · ·		

If more than one screen, show location of each on sketch

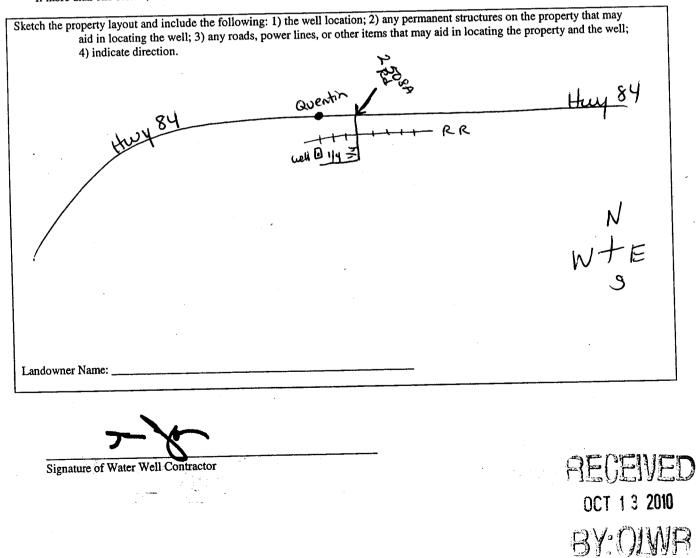

## ľ.