

# STATE WELL REPORT

## Part 1

### Driller's Log

Mississippi Department of Environmental Quality  
Office of Land and Water Resources  
P.O. Box 2309  
Jackson, MS 39225-2309  
(601)961-5210  
(601)360-0535 (fax)

#### For Office Use Only:

Well #: K110  
Aquifer: \_\_\_\_\_  
E-Log #: \_\_\_\_\_

County: Lincoln Franklin

Permit #: \_\_\_\_\_

Driller: Fitzgerald Water Well

Date drilling completed: 8-2-17

*State Law requires that this report be prepared by the license holder responsible for the work and filed with the Department at the above address within 30 days of completion of drilling of the well or borehole.*

Well Owner Information <small>(Landowner if borehole is not for a water well)</small>	Well or Borehole Location
Owner Name: <u>Betty Richardson</u>	Latitude: <u>31°27'35.9"N</u> Longitude: <u>90°38'05.2W</u>
Mailing Address: <u>Horse Creek Rd.</u>	Method of Lat/Long (check one): Conventional Survey _____ USGS quad _____, Hand-held GPS _____, Survey-grade GPS _____
<u>Bogue Chitto, Ms</u>	<u>SE 1/4 NE 1/4, Sec 30 T6N R6E</u>
City _____ State _____ Zip Code _____	_____ Miles _____ of _____ (Distance) (Direction) (Nearest Town)
Telephone No. (____) _____	

Well / Borehole Data
Date drilling started: <u>8-2-17</u> Date drilling completed: <u>8-2-17</u> Hole depth: <u>150'</u> Hole diameter: <u>8"</u>
Location of the source of any surface water used for drilling: _____
Method of dosing and volume of Chlorine used in drilling and development: _____
Logs run (circle all applicable): <u>No log run</u> Electric Gamma Ray Density Sonic Neutron Other: _____
Name of organization running log(s): _____
Purpose of borehole (circle one): <u>Water Well</u> Geotechnical/Geological Investigation Ground Source Heat Pump Seismic Survey Other (describe) _____
<i>If drilling is not related to water well construction, skip the remainder of this block</i>
Purpose of Well (circle all applicable): <u>Home</u> Industrial Public Supply Irrigation Fish Culture
Other (describe): _____
If a flowing well, method of flow regulation: Valve _____ Other (describe) _____
Static Water Level: <u>110'</u> feet [above or below] land surface Date measured: <u>8-2-17</u> <small>(circle one)</small>
Method of measurement (circle one): <u>Steel tape</u> Electric tape Air line Other (describe): _____
Well depth: <u>150'</u> Well grouted to a depth of: <u>10'</u> feet Type of grout (circle one): <u>Neat Cement</u> Bentonite Mix
Casing length: <u>140'</u> feet Casing diameter: <u>4"</u> inches Type of casing: <u>Pvc</u>
Screen length: <u>10'</u> feet Screen diameter: <u>4"</u> inches Type of screen: <u>Pvc</u>
Screen slot size: <u>.010</u> inches Setting depth: From <u>140'</u> feet to <u>150'</u> feet
Type of completion (circle all applicable): <u>Gravel packed</u> Underreamed Open hole Natural Development
Other (describe): _____
Top of lap pipe or reduction in casing: _____ feet
<i>If telescoped or more than one screen, describe on next page</i>



# STATE WELL REPORT

## Part 2

**Pump Installer's Completion Report**  
 Mississippi Department of Environmental Quality  
 Office of Land and Water Resources  
 P.O. Box 2309  
 Jackson, MS 39225  
 (601)961-5210  
 (601)961-5228 (fax)

County: Lincoln  
 Permit #: Franklin  
 Driller: Fitzgerald Water Well  
 Date completed: 8-2-17  
*Copy information from block on Part 1*

**For Office Use Only:**

Aquifer: \_\_\_\_\_  
 Well #: K110  
 Elevation: \_\_\_\_\_

*This part of the report must be completed by a licensed water well contractor or a licensed pump installer. A copy of Part 1 of the report must be attached and both parts filed with the Department at the above address within 30 days of well completion.*

Well Owner Information	Well Location
Owner Name: <u>Betty Richardson</u>	Latitude: <u>31° 21' 35.4" N</u> Longitude: <u>90° 38' 05.2" W</u>
Mailing Address: <u>Horse Creek Rd.</u>	Method of Lat/Long (check one): Conventional Survey _____
<u>Bogue Chitto, MS</u>	USGS quad _____, Hand-held GPS _____, Survey-grade GPS _____
City State Zip Code	<u>SE 1/4 NE 1/4 Sec 30 T 6 N R 6 E</u>
Telephone No. ( ) _____	Distance _____ Miles _____ of _____ Nearest Town

Pump Type Circle one	Power Type Circle one
Air Lift <input type="checkbox"/> Jet <input type="checkbox"/> <u>Submersible</u>	Diesel Engine <input type="checkbox"/> Gasoline Engine <input type="checkbox"/> Natural Gas <input type="checkbox"/>
Bucket <input type="checkbox"/> Piston <input type="checkbox"/> Turbine <input type="checkbox"/>	<u>Electric Motor</u> <input checked="" type="checkbox"/> Hand <input type="checkbox"/> Tractor PTO <input type="checkbox"/>
Centrifugal <input type="checkbox"/> Rotary <input type="checkbox"/> Flowing Well <input type="checkbox"/>	Windmill <input type="checkbox"/> Other (specify): <u>07 207</u>
Other (specify): _____	Horse Power Rating of Motor: <u>3/4</u>
Date Pump Installed: <u>8-2-17</u>	Setting Depth: <u>140 BY OLWR</u> feet
Rated Pump Capacity: _____ Gallons Per Minute	Number of Stages: <u>12</u>

Pump Test Data	Method of Measuring Water Level Circle one
Date Well Tested: _____	Air Line <input type="checkbox"/> Electric Measuring Line <input type="checkbox"/> <u>Steel Tape</u>
Static Water Level (A): _____ Feet Below Land Surface	Other (specify): _____
Pumping Water Level (B): _____ Feet Below Land Surface	For flowing well, measured shut in head: _____ feet
Drawdown [(B) - (A)]: _____ Feet Below Land Surface	Well yielded _____ GPM with a drawdown of _____ feet after _____ hours of pumping
Test Pumping Rate: _____ Gallons Per Minute	
Duration of Pump Test (minimum 4 hours): _____ hours	

This is for (circle one): New Well Replacement of Existing Pump Repair of Existing Pump

I HEREBY CERTIFY that the above statements are true to the best of my knowledge.

Brad Fitzgerald 029 Betty  
 Print Name of Pump Installer and License No. (if applicable) Signature of Pump Installer

1947

1947


1947

1947


1947

K110

Google Maps 31°27'35.9"N 90°38'05.2"W

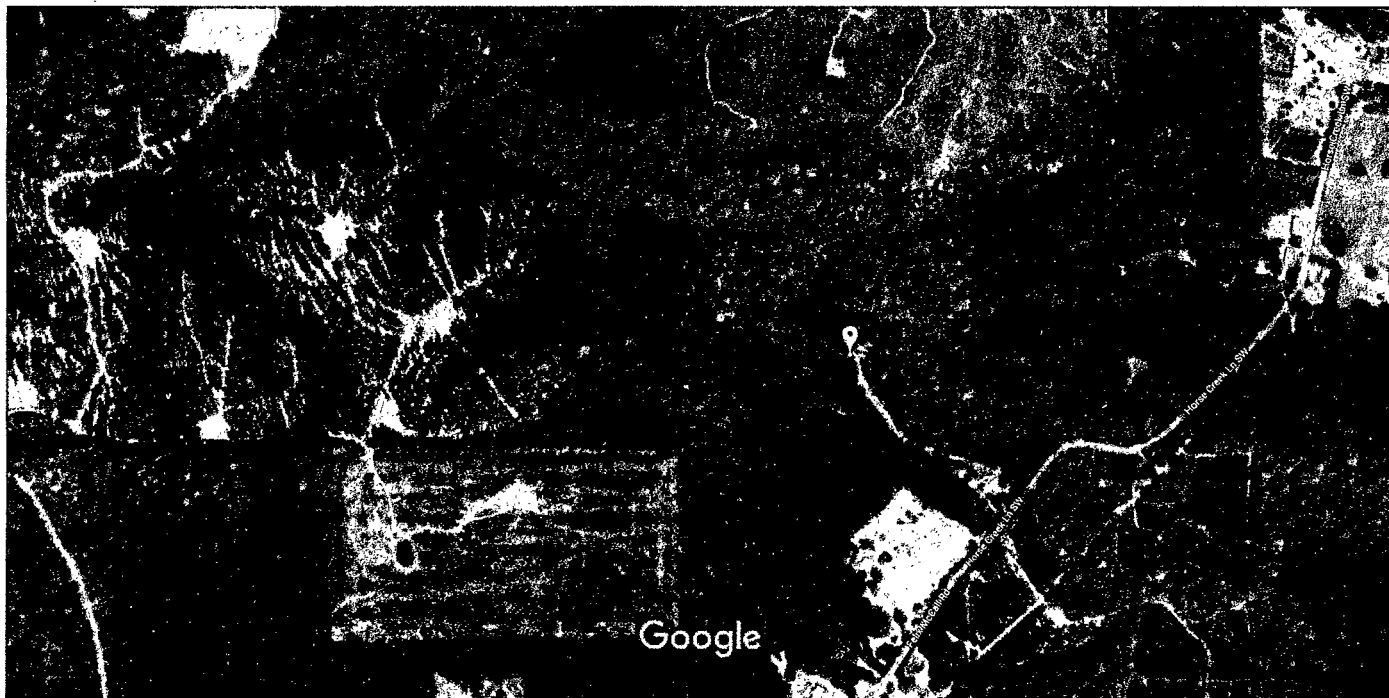

Imagery ©2017 Google, Map data ©2017 Google United States 200 ft

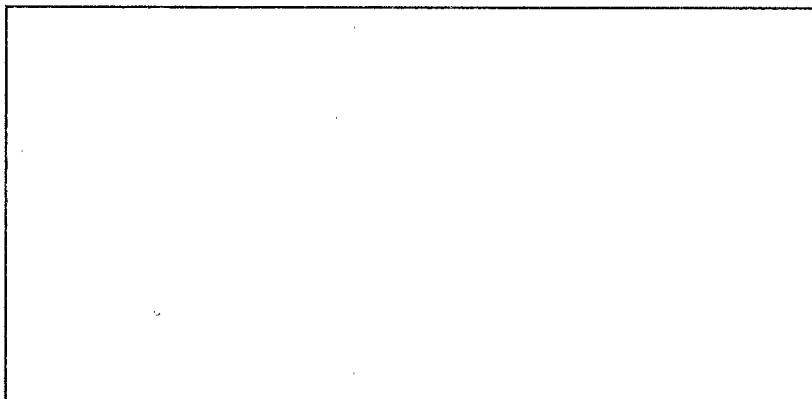

[REDACTED]  
 [REDACTED]  
 BY [REDACTED]

31°27'35.9"N 90°38'05.2"W

31.459965, -90.634788

Betty Richardson

150-110-140

3/4 HP

8-2-17