


FRANKLIN
L 7863

MISSISSIPPI DEPARTMENT OF NATURAL RESOURCES
Bureau of Land and Water Resources
Southport Mall
P.O. Box 10631
Jackson, Mississippi 39209
WATER WELL DRILLERS LOG

6/23 1986 Rayborn Drlg Co. Franklin
date well completed firm name county well located

LANDOWNER	description of formations encountered	from	to
Kermit Shell Rt 1 Box 214-A	Top soil	0	2
Roxie Ms 39661 (mailing address)	Shale	2	70
WELL LOCATION: sec. 40 T 5 N R 1 E S S 1/2 miles N of Garden City (distance) (direction) (nearest town)	Sand	70	167
WELL PURPOSE: home (home, irrigation, municipal, industrial)			
WELL COMPLETION DATA:			
(1) diameter (inches) 4"			
(2) total depth (feet) 167'			
(3) static water level (feet) 50' ^{below} above top of ground.			
(4) casing Sch 40 PVC, 157' (material) (depth) 4" If telescope see back. (size)			
(5) screen 10' 157' (length) (depth to top) 4" Sch 40 Slotted PVC (size) (material)			
(6) pump 1 H.P. 15 (HP) (yield gpm) electric (type power)			
(7) electric log no (yes or no) (organization running log)			
(8) how well bottom plugged wood			
DRILLERS REMARKS:			

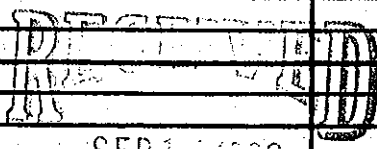

Department of Natural Resources
Bureau of Land & Water Resources